

GOVERNMENT CORNER RESTORATION FORM

FILED

TOWNSHIP 26S RANGE 7W SEC. 14 PLSS # 600400

Date: 3/12/2024 By: JC

This survey consists of:

DOUGLAS COUNTY OREGON

DATE 3-7-24

Map: \_\_\_\_\_  
Narrative: \_\_\_\_\_  
Corner Rpt: CS 67/57-38

Corner Designation

See COR 14/13  
23/24

DOUGLAS COUNTY  
SURVEYOR

Monument(s) Found: (Condition and Source)

Top 14" of BRASS CAP  
Iron Pipe Broken off  
Laying just below Ground

- Condition report
- Not Found
- Renewed
- Unrecorded
- Surveyed In

Previous Renewals Surface Remnant  
of Pipe near plumb position  
6" Below Ground

MONUMENT DETAIL

DCSO 1922 Vol 3 pg 131 M2-8

DCSO 1960 CS 49/129-3

Accessories Found

ORIG 30" Now

↳ 60" D. Fir N59°W 109.2 FT ADD 3 1/2"  
MAG NAIL Left Side Center

ORIG. 12" Now 32" W. OAK N38°E 165.3 FT  
(Rec N39°E 166.4 FT) Fully Healed Single  
BLAZE ADD 3 1/2" MAG NAIL RIGHT Side  
Center

Ed 1/2" Iron pipe on west side of  
Monument 6" below Ground

C.S. File 67/57-38

RENEWAL

Monument Set (Procedure and Description)

MONUMENT DETAIL

5/8" X 30" I. ROD WITH YELLOW  
DCSD PLASTIC CAP AT PLUMB  
POSITION OF FOUND MONUMENT  
APPROX 3" BELOW GROUND

New Accessories

5/8" X 30" IRON ROD WITH DCSD PLASTIC  
CAP N 51° E 31.0 FT UP 2"

Sketch of Monument, Accessories, and General Area


Location & Comments

OCRS COORDINATES  
COTTAGE GROVE - CANYONVILLE  
ZONE

N 170740.974

E 123427.142

Comp. Decline. 14 1/2° E  
Agency DCSD  
Party Chief S. F. HAUSE  
Note keeper  
Witnesses J. LORSUNG

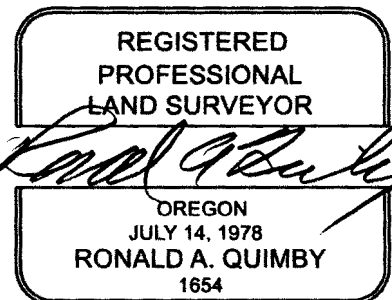

EXPIRES: 12/31/2024

CS 67/57-38

TOWNSHIP 26 RANGE 07 POINT IDENTIFIER # 600400

PRIMARY CORNER DESCRIPTION Sec Cor for 13, 14, 23 and 24

Alias _____	Description _____
Alias _____	Description _____
Alias _____	Description _____
Alias _____	Description _____

Original, Dennis Hathorn, under Contract #57 dated April 12, 1855 (DCSO records, Volume 11 Page 4598)

-----

Set post cor. secs. 13, 14, 23 and 24, from which

- A B.oak 24" dia., bears S.88°W., 577 lks. dist.
- A B.oak 24" dia., bears S.89°E., 756 lks. dist.
- A B.oak 20" dia., bears N.0°45'E., 361 lks. dist.
- A B.oak 15" dia., bears N.0°30'W., 441 lks. dist.

G.G. Stewart, Deputy Co. Surveyor - Dec. 1, 1922 - Wit. C. Croker; Blumburg; Will Long; Carpenter - Vol. 3 Pg. 131; M 2-8

-----

Reset from one original bearing tree.  
Drove Iron pipe 8" below ground in Prune orchard and 33 ft. south of fence.  
Marked the following trees:

- B.oak 12" dia., bears N.16½°W., 159.3 ft.
- B.oak 18" dia., bears N.36½°E., 176.5 ft.

No other trees suitable.

DECLINATION = 14 1/2° E RENEWED 3/8/24

-----

Doug. County Surveyors Office - James W. Byron, Deputy - Milo Godfrey; Clete Putnam - May 1960 - C.S. File 49/129-3

Found - ½" Iron pipe at corner and NE BT as recorded by Stewart. NW BT gone.

SEE BELOW Set brass cap at cor mkd: County Surveyor S14|S13 T26S R7W  
 Office, 1960 S23|S24  
 New BTS Now 66" 30" R. Fil. bears N.59°W., 109.2 ft. scribed S14 ADD 3 1/2" MAGNAN L.S.C.

DEAD ~~FALLEN TYPED OUT NO POSITION~~ Now 32" 7" Laurel bears ~~S.88°E., 167.6 ft. scribed S24~~ N 38° E 165.3  
 CS BT. W. Oak bears N.39°E., 166.4 ft. scribed S13 ADD 3 1/2" MAGNAN R.S.C.  
 T26S R7W CS BT. FHSB

FOUND TOP 14 INCHES OF BC MONUMENT BROKEN OFF AND BURIED JUST BELOW SURFACE AT CORNER LOCATION. REMAINDER OF B.C. MONUMENT IS IN NEAR PLUMB CONDITION APPROX 6 INCHES BELOW GROUND.

A 5/8" x 30" I.R. / DCSO IS SET AT THE PLUMB POSITION OF THE FOUND MON. YELLOW PLSTC. CAP

TOP OF I.R./CAP IS 3 INCHES BELOW SURF. FOUND 2" I.P. ON WEST EDGE OF NEW COR. MONUMENT. TOP IS 6" BELOW SURFACE.

NEW REFERENCE A 5/8" x 30" I.R. / DCSO SET PROT. 2"; BEARS N 51° E 310 FT. PLASTIC CAP

N 170740.974  
 E 123427.142 = OGRS CANYONVILLE COTTAGE GROVE COORD.S CS 6/57-38 23