

GOVERNMENT CORNER RESTORATION FORM

FILED

TOWNSHIP 26S RANGE 1W SEC. 10

PLSS # 460560

Date: 3/12/2024 By: X

This survey consists of:

DOUGLAS COUNTY OREGON

DATE 2-27-24

Map: \_\_\_\_\_

Narrative: \_\_\_\_\_  
Corner Rpt: 67/57-39

Corner Designation

NE 1/4 S10

DOUGLAS COUNTY  
SURVEYOR

Monument(s) Found: (Condition and Source)

2 1/2" BRASS CAP under  
PAVEMENT North Fog Line  
OF HWY 138

\_\_\_ Condition report

\_\_\_ Not Found

\_\_\_ Renewed

\_\_\_ Unrecorded

\_\_\_ Surveyed In

Previous Renewals

Set IN 1981 Per  
M 87-45 - Grubb

MONUMENT DETAIL

26S RIW  
NE 1/4 S10  
1981  
LS397

Accessories Found

2"x2" X chiseled in 2"x4"x10" Stone  
Set IN Concrete ON Top NE CORNER  
OF 516W FOUNDATION (SIGN FOR Bogus  
Creek CAMPground HAS BEEN REMOVED  
Bears S 71° 26' 02" W 112.46 FT

C.S. File 67/57-39

RENEWAL

Monument Set (Procedure and Description)

MONUMENT DETAIL

\_\_\_\_\_  
\_\_\_\_\_  
New Accessories

5/8" x 30" Iron Rod with DCSD plastic  
cap North 5.0 FT set flush with  
ground

Top Center of an 8" x 8" x 4.5 FT steel  
gate post the westerly post for  
gate to Bogus Creek Campground  
Bears N 48 1/2° W 115.0 FT

Sketch of Monument, Accessories, and General Area

Location & Comments


OCRS COORDINATE SYSTEM  
Cottage Grove - Canyonville  
Zone

AREA BURNED  
9-2020

N 179443.629  
E 305935.085

Comp. Decline 14 1/2° E  
Agency DOGO  
Party Chief S. F. HAUSE  
Note keeper  
Witnesses J. JOHNSON

REGISTERED  
PROFESSIONAL  
LAND SURVEYOR

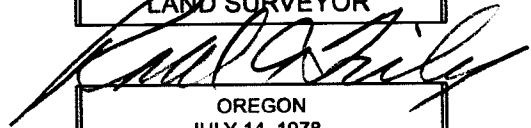

OREGON  
JULY 14, 1978  
RONALD A. QUIMBY  
1654

EXPIRES: 12/31/2024

CS 67/57-39  
213

Set original corner stone

7. Set: 2" X 30" iron pipe, 24" in the ground in a 3 ft. diameter mound of stone with a 3" brass cap marked:

Fd: 1" iron pipe, firmly set with a 2 1/2" stone

15.

T26S RIW  
1/1024 S10  
1981  
LS 397

from which new bearing trees:  
a 6" Douglas fir bears S. 63 1/2° E., 9.8 ft., scribed "1/1024 S10 BT".  
a 12" Douglas fir bears N. 5° W., 42.3 ft., scribed "1/1024 S10 BT".

8. Set: 2" X 30" iron pipe, 24" in the ground in a 3 ft. diameter mound of stone with a 2 1/2" brass cap marked:

from which the original  
a 18" Douglas fir, down &  
a 37" Douglas fir snag, be  
a 24" Douglas fir snag, be  
a 24" Douglas fir snag, be  
and bearing trees marked  
a 31" Douglas fir with scri  
blaze bears N. 79 1/2° E.,  
a 28" Douglas fir with scri  
blaze bears N. 64° W. 41.  
a 22" Douglas fir with scri  
blaze bears S. 70° W., 7.  
a 18" Douglas fir with scri  
double blaze bears S. 9°

T26S RIW  
N 1/16 S10  
C  
1981  
LS 397

from which new bearing trees:  
a 8" hemlock bears N. 39° W., 17.7 ft., scribed "CN 1/16 S10 BT".  
a 8" hemlock bears N. 72° E., 41.4 ft., scribed "CN 1/16 S10 BT".  
T26S, RIW 460560  
Set: 2" X 30" iron pipe, 36" in the ground with a 2 1/2" brass cap marked:

RENEWED 2/27/24

T26S RIW  
NE 1/16 S10  
1981  
LS 397

9. MONUMENT NOW UNDER PAVEMENT OF HWY. 138 AT NORTH FOG LINE.  
DID NOT UNCOVER, POSITION LOCALIZED WITH from which: PIN FINDER.

a 2" X 2" "X" chiseled in a 2" X 4" X 10" stone set in concrete on the top ~~W. E.~~ corner of the "Umpqua National Forest Picnic Ground Bogus Creek" sign post foundation and --- SIGN HAS BEEN REMOVED, FOUNDATION INTACT. located on the South side of ORE 138 at Bogus Creek Park bears S. 71° 26' 02" W., 112.46 ft.  
a 2" X 2" "X" chiseled in a 4" X 8" X 8" stone set in concrete on the top S. W. corner of the "Umpqua National Forest Campground Bogus Creek" sign post foundation and located on the North side of ORE 138 at Bogus Creek Park bears S. 75° 02' 08" E., 177.19 ft.  
SIGN AND FOUNDATION REMOVED NO EVIDENCE REMAINS

S. W.

10. Fd: 1" iron pipe, firmly set, projecting 2" above the ground in a 2 1/2 ft. diameter mound of stone with a 2 1/2" brass cap marked:  
T26S RIW  
1/4  
S9 S10  
PE 5188  
1977

from which new bearing trees:  
a 22" hemlock with scribe marks "1/4 S9 BT" visible on an open, unhealed blaze bears S. 84° W., 48.4 ft.  
a 19" hemlock with scribe marks "1/4 S10 BT" visible on an open, unhealed blaze bears S. 46 1/4° E., 24.4 ft.

11. Set: 2" X 30" iron pipe, 30" in the ground in a 2 1/2 ft. diameter mound of stone with a 2 1/2" brass cap marked:  
T26S RIW  
C 1/4 S10  
1981  
LS 397

from which new bearing trees:  
a 2" X 30" iron pipe, 24" in the ground in a 3 ft. diameter mound of stone with a 3" brass cap marked:  
T26S RIW  
1/1024 S10  
1981  
LS 397

from which the original  
a 18" Douglas fir, down &  
a 37" Douglas fir snag, be  
a 24" Douglas fir snag, be  
a 24" Douglas fir snag, be  
and bearing trees marked  
a 31" Douglas fir with scri  
blaze bears N. 79 1/2° E.,  
a 28" Douglas fir with scri  
blaze bears N. 64° W. 41.  
a 22" Douglas fir with scri  
blaze bears S. 70° W., 7.  
a 18" Douglas fir with scri  
double blaze bears S. 9°

15. Fd: 1" iron pipe, firmly set with a 2 1/2" stone  
DECLINATION 14 1/2 °E  
"I, George E. Grubb, a regi  
this plat and the notes hereon  
May, 1981, for the U. S. Forest  
and with the Articles of my cont

SURVEYOR'S CERTIFICATE

SURVEYOR'S CERTIFICATE

SURVEYOR'S CERTIFICATE