

GOVERNMENT CORNER RESTORATION FORM

TOWNSHIP 26S RANGE 1W SEC. 30 PLSS # 100240

FILED
Date: 4/9/2024 By: SC
This survey consists of:

DOUGLAS COUNTY OREGON

DATE 3-25-24

Map: _____
Narrative: _____
Corner Rpt: CS 67/57-43

Corner Designation

W 1/4 S30 only

DOUGLAS COUNTY
SURVEYOR

Monument(s) Found: (Condition and Source)

2 1/2" DCSD BRASS CAP

- Condition report
- Not Found
- Renewed
- Unrecorded
- Surveyed In

Previous Renewals

GLD 1916 Vol 10 pg 4283

DCSD 1966 CS 52/77-14

MONUMENT DETAIL

County Surveyors
OFFICE

T26S

R2W | 1/4 S30 R1W
1966

Accessories Found

38" CEDAR N49°E 16.5 FT GOOD SCAR
ADD 3 1/2" MAG NAIL RIGHT SIDE CENTER

39" D. FIR S27 1/2°E 66.7 FT GOOD SCAR
ADD 3 1/2" MAG NAIL RIGHT SIDE CENTER

24" Hemlock S77°E 94.5 FT GOOD SCAR
ADD 3 1/2" MAG NAIL RIGHT SIDE CENTER

C.S. File 67/57-43

Monument Set (Procedure and Description)

MONUMENT DETAIL

Horizontal lines for Monument Set description.

New Accessories

Horizontal lines for New Accessories description.


Sketch of Monument, Accessories, and General Area

Location & Comments

OCRS COORDINATE SYSTEM
Cottage Grove - Canyonville
Zone

N 162228.222
E 286732.832

Location & Comments section with handwritten notes:
Comp. Decline. 14 1/2° E
Agency DCSO
Party Chief J. Lorusso
Note keeper
Witnesses

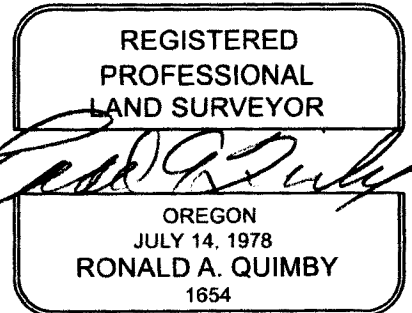

EXPIRES: 12/31/2024

CS 67/57-43
213

PRIMARY CORNER DESCRIPTION W. 1/4 Cor. for Sec. 30 only

Alias _____	Description _____
Alias _____	Description _____
Alias _____	Description _____
Alias _____	Description _____

GLO survey by Fred Mensch, Deputy Surveyor, under Contract #797, dated April 19, 1910 - (DCSO records Vol. 10 Page(s) 4155-56)

The length of the W. bdy. of sec. 30 is 80.08 chs. Therefore at point midway on this line (6.60 chs. N.1°20' of the 1/4 sec. cor. on E. bdy. of sec. 25, T26S R2W) I establish 1/4 sec. cor. on W. bdy. of sec. 30 as follows:
 Set a basalt stone 15x12x10 ins., 10" in the ground for 1/4 sec. cor. on W. bdy. of sec. 30, marked 1/4 on E. face, from which

- A Cedar 30" dia., bears N.3 1/2°E., 38 lks. dist. mkd. 1/4 S30 BT.
- A Cedar 30" dia., bears S.29°E., 55 lks. dist. mkd. 1/4 S30 BT.

GLO Survey by Fred Mensch, U.S. Surveyor Under Special Instructions dated May 25, 1916 - (DCSO records Vol. 10 Page(s) 4283)

At a point from which the 1/4 cor. of sec. 30, (established by Deputy Mensch in 1910 which is a basalt stone 15x12x10 ins., firmly set, marked and witnessed as described by the surveyor general) bears N.89°42'W., 52 lks. dist.
 To this point, I now move the original corner stone, which I set 10" in the ground, for 1/4 cor. of sec. 30, marked 1/4 on E. face; from which

- A Cedar 18" dia., bears N.49°E., 25 lks. dist. mkd. 1/4 S30 BT.
- A Cedar 14" dia., bears S.60°E., 55 lks. dist. mkd. 1/4 S30 BT.

I now destroy marks on bearing trees at former cor.

Douglas County Surveyors Office - Vernon "Ray" Tracy and crew May 19, 1966 - C.S. File 52/77-14

Found - ✓ Orig. 18" now ~~18"~~^{38"} Cedar N.49°E., 16.5 ft., alive and shows old "1/4 S30 BT" scribe on unhealed blaze.
 No trace of SE. BT due to cat logging.
 No trace of stone called for.

Set Brass cap at cor. mkd: County Surveyors Office
 T 26 S
 R 2 W | 1/4 S30 R1W
 1966

New BTs - ✓ ^{39"} 28" D. Fir S.27 1/2°E., 66.7 ft. mkd. 1/4 S30 CS BT.
 ✓ ^{22"} 22" Hemlock S.77°E., 94.5 ft. mkd. 1/4 S30 CS BT.

This corner lies approx. 60 ft. S. of Thunder Mt. Road.

All side spiked
 w/new tags

CS 67/57-43
 3/3

1