

GOVERNMENT CORNER RESTORATION FORM

FILED

TOWNSHIP 26S RANGE 3W SEC. 2

PLSS # 540600

Date: 4/9/2024 By: [Signature]

This survey consists of:

Map: _____

Narrative: _____

Corner Rpt: CS 67/57-45

DOUGLAS COUNTY SURVEYOR

Corner Designation

$\frac{1}{4} \frac{2}{11}$

Monument(s) Found: (Condition and Source)

BRASS CAP

___ Condition report

___ Not Found

Renewed

___ Unrecorded

___ Surveyed In

Previous Renewals

See PLSS 540600

T26S R3W

MONUMENT DETAIL

Douglas County

T26S R3W

$\frac{1}{4} \frac{2}{11}$

CS 2603

Accessories Found

BURNED - Rotted 28" X 1 FT FIR STUMP N176°E
26.5 FT NO MARKS

BURNED - SAWN 38" X 2 FT FIR STUMP S25°14'W
54.3 FT Healed BLAZE ADD 3 1/2" MAG NAIL
TOP CENTER

BURNED - SAWN 22" X 6.5 FT FIR STUMP N73°E
59.0 FT Healed BLAZE ADD 3 1/2" MAG NAIL
RIGHT SIDE CENTER

25" D. FIR S4 1/2°E 63.5 FT Healed BLAZE
ADD 3 1/2" MAG NAIL RIGHT SIDE CENTER

BURNED SAWN 27" X 3 FT FIR STUMP N35°W
14.3 FT Healed BLAZE ADD 3 1/2" MAG NAIL
TOP CENTER

C.S. File 67/57-45

New Accessories

Sketch of Monument, Accessories, and General Area


Location & Comments

@CRS Coordinate System
 Cottage Grove - Canyonville
 Zone

AREA BURNT
9-2020

N 181538.058
 E 246830.932

Comp. Decline 14 1/2° E
 Agency DCSO
 Party Chief S. Flouse
 Note keeper
 Witnesses J. Lorusso

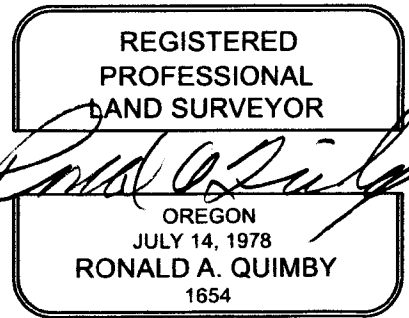

EXPIRES: 12/31/2024

CS 67/57-45 2/3

PRIMARY CORNER DESCRIPTION 1/4 Cor. Secs. 2 & 11

Alias _____	Description _____
Alias _____	Description _____
Alias _____	Description _____
Alias _____	Description _____

as documented in the report by Covington, dated May 10, 2017; monumented with an iron post, 1 1/4" dia., firmly set, projecting 9" above ground, in a mound of stone, 4 ft. base, to the top, with a brass cap mkd.

DOUGLAS COUNTY

T 26 S R 3 W

1/4 S 2
S 11

LS 2603

ALL NEW TAGS & SIDE STAKES

from which the remains of a bearing tree mkd. by Cole
A fir stump, 18" dia., bears S.46°E., 45.8 ft. with no marks visible.

BURNED TO GROUND

and the remains of the bearing trees mkd. by Byron
A fir stump, 34" dia., bears N.76°E., 26.5 ft., with a healed blaze. BLAZE GONE

BURNED ROTTED 28" x 1 FT.

A fir, 26" dia., bears S.25 3/4°W., 54.3 ft., with a healed blaze

BURNED SAWN 38" x 2 FT. STUMP

and the bearing trees mkd. by Christensen in 1999
A fir, 20" dia., bears N.73°E., 59.0 ft., with a healed blaze

BURNED SAWN 22" x 6" STUMP

A fir, 21" dia., bears S.4 1/2°E., 63.5 ft., with a healed blaze

SINGED ALIVE 25" AD

A fir, 26" dia., bears N.35°W., 14.3 ft., with a healed blaze

BURNED SAWN 27" x 3 FT. STUMP

An iron rod, 5/8" dia., firmly set, projecting 7" above ground, established by person(s) unknown, is alongside the cor.

Corner is located on a S. slope, alongside a fence extending N. and S.

From this cor., a point erroneously established as the 1/4 sec. cor. of secs. 2 and 11 by Baughman, in 1974, subsequently rejected by Shaner, in 1976, further perpetuated by Monrean, in 1976, recovered by Monrean, in 1985, further perpetuated by Christensen, in 1998, and rejected by Christiansen, as documented in the report by Covington, dated May 10, 2017, bears S.29°01'35" W., 120.01 ft.; and was not utilized for control in the course of this survey due to improper procedure; monumented with an iron post, 1 1/4" dia., firmly set, projecting 5" above the ground, with an unmarked brass cap, from which bearing trees mkd. by Baughman

A fir, 30" dia., bears S.10°E., 25.3 ft., with a healed blaze.

A fir, 13" dia., bears N.11 1/2°W., 23.2 ft., with a healed blaze.

and the bearing trees mkd. by Christensen in 1998

A fir, 24" dia., bears N.25 1/2°E., 26.0 ft., with a healed blaze.

Continued next page

CS 67/57-45