

GOVERNMENT CORNER RESTORATION FORM

FILED

TOWNSHIP 26S RANGE 2W SEC. 29

PLSS # 240240

Date: 4/9/2024 By: SC

This survey consists of:

DOUGLAS COUNTY OREGON

DATE 4-2-24

Map: _____

Narrative: _____
Corner Rpt: CS67/57-49

DOUGLAS COUNTY
SURVEYOR

Corner Designation

C 1/4 S 29

Monument(s) Found: (Condition and Source)

BLM BRASS CAP
UP 2"

Condition report

Not Found

Renewed

Unrecorded

Surveyed In

Previous Renewals

BLM Established 1993
Vol 51 pg 19424

MONUMENT DETAIL

Accessories Found

BURNED DEAD 12" Red Cedar 526³/₄° E
30.5 FT (REC 45 LKS 29.7 FT) BURNED OUT
FACE ADD 3¹/₂" MAG NAIL RIGHT side Center

Burnt SAWN 18" X 3" Hemlock Stump 568¹/₂° W
10.6 FT (REC 15 LKS 9²/₂ FT Fully Healed
Single BLAZE ADD 3¹/₂" MAG NAIL TOP
Center

C.S. File 67/57-49
1/3

Monument Set (Procedure and Description)

MONUMENT DETAIL

Blank lines for Monument Set description.

New Accessories

Blank lines for New Accessories description.

Sketch of Monument, Accessories, and General Area

Location & Comments

Burned Forest To EAST
Clearcut To West

Mon on steep N.
Slope 50' N. OC
SKID RD LANDING


OCR 2 COORDINATE SYSTEM
COTTAGE GROVE - CANYONVILLE
ZONE

AREA BURNED
9-2020

N 194278.884

E 262539.126

Comp. Decline. 14 1/2° E
Agency DCSO
Party Chief S.F. HAUSE
Note keeper
Witnesses J. LORSUNG

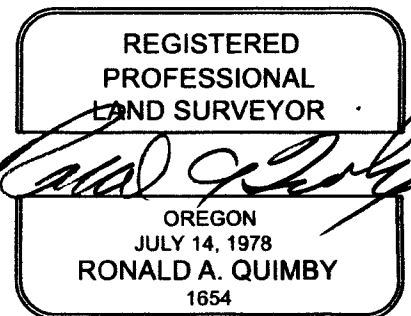

EXPIRES: 12/31/2024

CS 67 / 57-49

TOWNSHIP 25 RANGE 02 POINT IDENTIFIER # 240240

PRIMARY CORNER DESCRIPTION Center 1/4 Sec. 29

Alias _____	Description _____
Alias _____	Description _____
Alias _____	Description _____
Alias _____	Description _____

BLM Dependent resurvey by Wayne Rogers, Cadastral Surveyor & Robert Browning, Surveying Technician, under Group #1659, surveyed June/July 1993 - (DCSO records Vol. 51 Page 19424)

DECLINATION $14\frac{1}{2}^{\circ}E$

RENEWED 4/2/24

Point for the center 1/4 sec. cor. of sec. 29, at intersection with the E and W centerline.

Set a stainless steel post, 28" long, $2\frac{1}{2}$ " dia., 28" in the ground, with brass cap mkd.

T25S R2W
C1/4 S 29
1993

PROT. 2"

ADD 3 1/2" MAGNAIL
RSC TO FOUND

from which

cedar, 8" dia., bears S. $26\frac{1}{4}^{\circ}E$, 45 lks., mkd. C1/4 S29 BT

A hemlock, 13" dia. bears S. $68\frac{1}{2}^{\circ}W$, 15 lks. mkd. C1/4 S29 BT

Deposit a white "DEEP-1" magnetic marker at the base of the stainless steel post.

BURNED DEAD 12" AR
BURNED SAWN
18" x 3 FT STUMP

292' 30" E

BTS

BURNED OUT
FACE

98/106

FHSB

MON. ON STEEP NORTH SLOPE ~ 50 FT. NORTH OF SKID RD. LANDING,
BURNED FOREST TO EAST, CLEARCUT TO WEST.

CCRS CANYONVILLE COTTAGE GROVE COORD.S

194278.884 N

262539.126 E

CS 52/52-49
3/3