

GOVERNMENT CORNER RESTORATION FORM

FILED

TOWNSHIP 27 RANGE 6 SEC. 27 PLSS # 400240

Date: 5/7/2024 By: [Signature]
This survey consists of:

DOUGLAS COUNTY OREGON

DATE 4/24/2024

Map: _____
Narrative: _____
Corner Rpt: C67/57-52

Corner Designation

1/4 S28/S27

DOUGLAS COUNTY
SURVEYOR

Monument(s) Found: (Condition and Source)

2 1/2" BC/IP, up 14"

- Condition report
- Not Found
- Renewed
- Unrecorded
- Surveyed In

Previous Renewals

DCSD 1961 CS 49/79-13

DCSD 1984 CS 62/18-2

Lang 1992 FD 1992-0040

DCSD FD 2023-0004

MONUMENT DETAIL

Accessories Found

Broken, rotted stub, y. Oak, ^{bears} N54°W 56.8ft. Orig BT

39" trunk of a double trunk I. Cedar with healed blaze bears S 4 1/2° E 28.7 ft to center of root crown. 1961

A 30" trunk of a double trunk I. Cedar is situated on line between monument & BT

21" W. Oak with healed blaze bears N 48°W 21.4 ft. ADD

3 1/2" Mag nail Left Side Center 1961

15" I Cedar bears S 55°W 16.8ft (rec 16.6) ^{with} fully healed double blaze, ADD 3 1/2" Mag nail Right Side Center (1984)



New Accessories

30" Madrone, scribed "1/4 BT" on double blaze, bears
 N 23° E 16.0 ft. 3 1/2" mag nail right side center

Sketch of Monument, Accessories, and General Area

Location & Comments

Comp. Decline. 14 1/2° E
 Agency _____
 Party Chief Stephen Flouse
 Note keeper " "
 Witnesses Jeff Loring

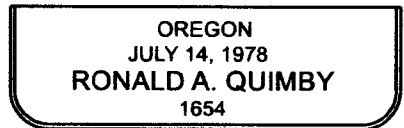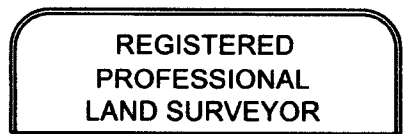

EXPIRES: 12/31/2024

CS 67/57-52
2/3

TOWNSHIP 27 RANGE 06 POINT IDENTIFIER # 400240

PRIMARY CORNER DESCRIPTION 1/4 Cor. for Secs. 27 and 28

Alias _____	Description _____
Alias _____	Description _____
Alias _____	Description _____
Alias _____	Description _____

Original - Elder & Gile, Contract #31 dated April, 1853

 Set 1/4 sec. post, from which
 A Y.oak 12" dia. bears N.76°E., 73 lks. dist.
 A Y.oak 12" dia. bears N.54°W., 86 lks. dist.

James W. Byron, Deputy County Surveyor - Milo Godfrey
 Clete Putnam - January, 1961 - C.S. File 49/79-13

 Found - 12" B.Oak now 22", N.54°W., 56.8 ft. Cut open &
 found good scribing "1/4S". Tree alive and
 standing.
 No trace of NE BT. Brush pile surrounds location.
 Set - Brass cap mkd. County Surveyor's Office, 1961 1/4
 S28|S27 T27S R6W
 New BTs - 20" I. Cedar S.2 1/2°E., 28.7 ft. mkd. 1/4 S27 CS BT.
 12" W.Oak N.48°W., 21.4 ft. mkd. 1/4 S28 CS BT.

Doug. Co. Surveyors Office - Larry E. Monrean, Deputy
 S.J. Flause - May 9, 1984 - C.S. File 62/18-2 **DECLINATION 14 1/2° E**

 Found ^{2 1/2"} 1" I.P. ^{B.C.} w/BC (properly mkd) protrudes 14" above
 ground.
NOW BROKEN ROTTED STUB ~~12"~~ Y.Oak now ~~22"~~ B.Oak previously opened by Byron
 has fragmentary scribing visible on partially
 re-healed blaze. This tree is in good condition
 & bears N.54°W, 56.8 ft. (orig. BT)
 (Original NE BT not found.)
NOW 39" ~~20"~~ now ~~27"~~ trunk of a double trunk I. Cedar with
 well healed double blaze bears S.4 1/2°E, (Rec.
 S.2 1/2°E.) 28.7 ft. to center of root crown. A
 ~~30"~~ ~~20"~~ trunk of a double trunk I. Cedar is situated
 on line between monument & bearing tree.
NOW 21" ~~12"~~ W.Oak with well healed double blaze bears N.48°W
 21.4 ft. **ADD 3 1/2" MAG NAIL LSC**
 New BT - ~~10"~~ I. Cedar double blazed 7 scribed "1/4 S28 CS BT"
 NOW 15" bears S.55°W, ~~16.6~~ ft. **FHDB ADD 3 1/2" MAG NAIL RSC**
 (See sketch in file) **16 B**

Found BC and 4 BTs - Greg Lang - April, 1992 - Partition 1992-0040

Fd. 12/2022 by DCSO Ron Quimby - 2023-0004

NEW BT
30" MADRONE SCRIBED 1/4 BT ON A DOUBLE BLAZE N23°E, 16° FT. DIST
3 1/2" MAG NAIL RSC