

GOVERNMENT CORNER RESTORATION FORM

FILED

TOWNSHIP 25 1/2 S RANGE 1 E SEC. 31 PLSS # 140200

Date: 5/16/2024 By: JC
This survey consists of:

Map: _____

DOUGLAS COUNTY OREGON

DATE 5/13/24

Narrative: _____
Corner Rpt: CS 67/57-58

DOUGLAS COUNTY
SURVEYOR

Corner Designation

1/4 cor 31 only 31

Monument(s) Found: (Condition and Source)

2 1/2" GLD BRASS CAP
ON 1" I.D.I.P. UP 6" IN
ROUGH STONE MOUND

Previous Renewals

GLD RESURVEY 1921 Vol 22 pg
9237-38

DCSO 1962 CS 52/30-11
DCSO 1966 CS 52/30-28A

- Condition report
- Not Found
- Renewed
- Unrecorded
- Surveyed In

MONUMENT DETAIL

1/4 231
1928

Accessories Found

BURNED-DEAD 14" R. CEDAR 555°E 10.3 FT
(Rec 16 LKS) BLAZE NOT VISIBLE ADD
3 1/2" MAG NAIL RIGHT SIDE CENTER

DOWN BURNED UP FIR 523W 37° (Rec
56 LKS) ROOT HOLE AND TAG

C.S. File 67/57-58

RENEWAL

Monument Set (Procedure and Description)

MONUMENT DETAIL

New Accessories

41" BURNED DEAD D. FIR S1°W 34.1 FT
3 1/2" MAG NAIL RIGHT SIDE CENTER

31" BURNED - DEAD R. CEDAR N70°W
17° FT 3 1/2" MAG NAIL RIGHT SIDE CENTER

Sketch of Monument, Accessories, and General Area

Location & Comments

BURNED OLD GROWTH TO
SOUTH CLEARCUT TO NORTH
OCRS COORDINATE SYSTEM
COTTAGE GROVE CANYONVILLE
ZONE

CORON FLAT Ground
NEAR BOTTOM OF
MODERATE SOUTH
SLOPE

AREA BURNED
9/20/2010

Comp. Decline. 14 1/2° E


Agency DCSO

Party Chief S. F. HAUSE

Note keeper

Witnesses J. CORSUNG

N 188901.729
E 319991.659

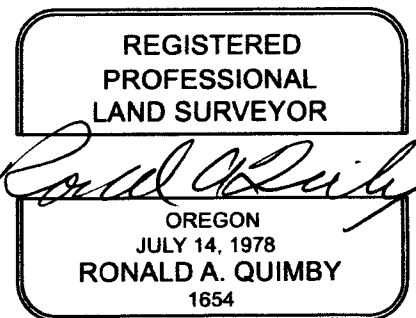

EXPIRES: 12/31/2024

CS 67/57-58

2/3

RENEWED 5/13/24

TOWNSHIP 25 RANGE 01 POINT IDENTIFIER # 656100

PRIMARY CORNER DESCRIPTION No 1/4 Cor for Sec 31, T25-1E

Alias	Description
	AKA 140200
Alias	Description
Alias	Description
Alias	Description

GLO resurvey by Otto L. Draper, U.S. Transitman - Under instructions dated March 12, 1921 - (DCSO records Vol. 22 Page(s) 9237-38)

Point for the 1/4 sec. cor. of sec. 31 only. Set an iron post 3 ft. long, 1" dia., 27" in the ground, for the 1/4 sec. cor. of sec. 31 only, with brass cap mkd.

from which
 Cedar 5" dia., bears S.55°E., 16 lks. dist. mkd. ~~1/4 S31~~
 BT. ~~BLZ.~~ NO LONGER VISIBLE
 Fir 20" dia., bears S.23°W., 56 lks. dist. mkd. 1/4 S31
 BT.
 103
 ADD 3 1/2" MAG NAIL R.S.C.
 2 1/2" B.C. / 1" ID IP
 ROOT 6" HAS ROUGH MOUND OF STONE
 ROOT HOLE FND. TAG
 372

Milo E. Godfrey, Deputy - Vernon Tracy Mike Stone - Aug. 1962 - C.S. File 52/30-11

Found - GLO brass cap & both BTs mentioned in 1928 survey - all in good condition.

DECLINATION 14 1/4° E
FD 10/1966 DCSO VRT, JH, & DW - 10/1966 - C.S. File 52/30-28A

NEW REFS

41" BURNED DEAD D. FIR 3 1/2" MAG NAIL R.S.C, S 01° W, 34'

31" BURNED DEAD R. CEDAR " " " " N 70° W, 70'

MONUMENT ON FLAT GROUND NEAR BOTTOM OF MODERATE SOUTH SLOPE
BURNED OLD GROWTH TO SOUTH, CLEARCUT TO NORTH

OCRS CANYONVILLE COTTAGE GROVE COORD,S
188901.729 N
319991.659 E

CS 67/57-58
313

BURNED DEAD 14" R.

FALLEN BURNED UP

MINI GIS
43.34985
122.74738