

GOVERNMENT CORNER RESTORATION FORM

FILED

TOWNSHIP 25S RANGE 10 SEC. 6

PLSS # 109460

Date: 5/21/2024 By: X

This survey consists of:

Map: _____

DOUGLAS COUNTY OREGON

DATE 5-15-24

Narrative: _____

Corner Rpt: CS 67/58-1

Corner Designation

S.E. COR Lot 6

DOUGLAS COUNTY
SURVEYOR

Monument(s) Found: (Condition and Source)

None

___ Condition report

___ Not Found

Renewed

___ Unrecorded

___ Surveyed In

Previous Renewals

Established by EDWARDS
IN 156-53

MONUMENT DETAIL

Accessories Found

BURNED DEAD 13" FIR N 4°E 7.9 FT
PARTY HEADED SINGLE BLAZE ALL SCRIBING
VISIBLE WAD 3 1/2" MAG NAIL RIGHT SIDE
CENTER

C.S. File CS 67/58-1

RENEWAL

MONUMENT DETAIL

Monument Set (Procedure and Description)

A 2 1/2" Alum Cap on
30" Iron Rod
up 4"

Douglas County
Surveyors Office
1/16 +

New Accessories

5/8" x 60" Iron Rod with DCSO plastic
cap up 3" East 57.7 FT - N Landing
Shoulder

Sketch of Monument, Accessories, and General Area

Location & Comments


OCRS Coordinate System
Cottage Grove - Canyonville
Zone

AREA BURNT
9-2020

N 219222.312
E 288330.843

Comp. Decline. 14 1/2° E
Agency DCSO
Party Chief S. E. Hulse
Note keeper
Witnesses J. L. Orsuing

REGISTERED
PROFESSIONAL
LAND SURVEYOR

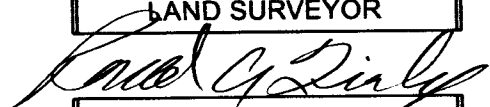

OREGON
JULY 14, 1978
RONALD A. QUIMBY
1654

EXPIRES: 12/31/2024

CS 67/58-1