

GOVERNMENT CORNER RESTORATION FORM

FILED

TOWNSHIP 255 RANGE 1W SEC. 18 PLSS # 114440

Date: 6/6/2024 By: X  
This survey consists of:

DOUGLAS COUNTY OREGON

DATE 5/29/2024

Map: \_\_\_\_\_  
Narrative: \_\_\_\_\_  
Corner Rpt: CS 67/58-5

DOUGLAS COUNTY  
SURVEYOR

Corner Designation

C 80 1/16 S 18

Monument(s) Found: (Condition and Source)

2 1/2" Alum. CAP ON 5/8"  
Rebar up 3"

- Condition report
- Not Found
- Renewed
- Unrecorded
- Surveyed In

Previous Renewals

(E) Established by Rice  
1999 M 159-39

MONUMENT DETAIL

1/16  
C — 80  
5/8  
2009  
54633LS

Accessories Found

BURNED - DEAD 27" D. Fir N 30° W 7.6 FT  
(Rec 6.8) Scribing visible on partly  
Healed BLAZE Add 3 1/2" NING NAIL  
RIGHT Side Center

BURNED DEAD 19" D. FIR S 76° E 23.5 FT  
(Rec S 74° E 23.7 FT) BURNED OUT BLAZE  
ADD 3 1/2" NING NAIL RIGHT Side Center  
Metal Post 0.6 FT EAST.

Blank lines for Monument Set (Procedure and Description)

New Accessories

Blank lines for New Accessories

Sketch of Monument, Accessories, and General Area


Location & Comments

OCRS COORDINATE SYSTEM  
Cottage Grove - Canyonville  
Zone

MON ON Steep South  
Slope IN CHARGE burned  
CLEAR CUT 160 FT  
SOUTH OF GRAVEL  
ROAD

~~N 268 546 - 071~~ N 207 179 . 454  
~~E 29 10 23 . 140~~ E 289 783 . 438

AREA BURNED  
9-2020  
Comp. Decline. 14 1/2° E  
Agency DCSO  
Party Chief S. F. MAUSE  
Note keeper  
Witnesses J. LOBSUNG

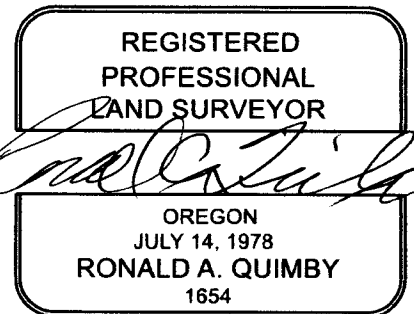

EXPIRES: 12/31/2024

CS 67/58-5  
213

