

GOVERNMENT CORNER RESTORATION FORM

TOWNSHIP 25S RANGE 1W SEC. 7 PLSS # 100540

FILED
Date: 6/10/2024 By: [Signature]
This survey consists of:

DOUGLAS COUNTY OREGON

DATE 5-30-24

Map: _____
Narrative: _____
Corner Rpt: CS67/58-7

Corner Designation

W 1/4 S7 only

DOUGLAS COUNTY
SURVEYOR

Monument(s) Found: (Condition and Source)

1 3/4" steel cap punch
MARK NEAR Center

Proj 4"

Previous Renewals

Hosford 1949-1950 CS

40/279 M 12-61

DCSO 1967 CS 52/30-83

Ness 1995 M 123-3A-B

- Condition report
- Not Found
- Renewed
- Unrecorded
- Surveyed In

MONUMENT DETAIL

Accessories Found

BURNED - Rotted 26" x 6 FT D. FIR STUMP
N 85° 07' E 33.2 FT HEALED FACE

BURNED AT base 34" D. FIR S 48° 20' E
12.0 FT HEALED FACE ADD 3 1/2" WAG NAIL
RIGHT SIDE CENTER

RENEWAL

Monument Set (Procedure and Description)

MONUMENT DETAIL

New Accessories

BURNED AT BASE 22" D. FIR N 2° W
27.5 FT 3 1/2" MAG NAIL RIGHT SIDE CENTER

BURNED AT BASE 33" D. FIR N 14° E
34.5 FT 3 1/2" MAG NAIL RIGHT SIDE CENTER

Sketch of Monument, Accessories, and General Area


Location & Comments

OCRS COORDINATE SYSTEM
COTTAGE GROVE - CANYONVILLE
ZONE

N 212501.091
E 286083.281

MON IN MIXED OLD GROWTH
AND REPROD NEAR TOP OF
EAST BANK OF SHALLOW S.E
RUNNING DRAW CREEK @
S 45° W 20' ±

AREA BURNED
9/2020
Comp. Decline. 14 1/2° E
Agency DCSO
Party Chief S. F. HAUSE
Note keeper
Witnesses J. LORSUNY

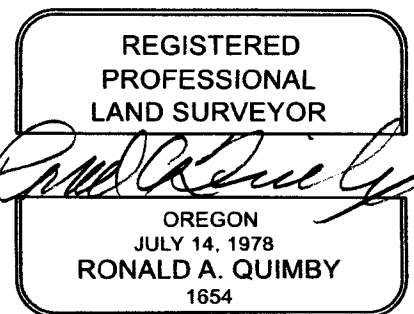

EXPIRES: 12/31/2024

CS 67/58-7

TOWNSHIP 25 RANGE 01 POINT IDENTIFIER # 100540

PRIMARY CORNER DESCRIPTION W 1/4 Cor. Sec 7 only

| | |
|-------------|-------------------|
| Alias _____ | Description _____ |
| Alias _____ | Description _____ |
| Alias _____ | Description _____ |
| Alias _____ | Description _____ |

V. W. Hosford, Surveyor - May 1949/Oct. 1950 - C.S. File 40/279 and M 12-61

I Set a 1" I.P. with steel cap from which
 A Fir 18" dia., bears N.85½°E., 32.1 ft. mkd. T25S R1W ¼
 S7 P.S. 253 BT.
 A Fir 14" dia., bears S.46½°E., 11.6 ft. mkd. T25S R1W ¼
 S7 P.S. 253 BT.

MAY 30, 2024

Ed. OK, DCSO, V. Tracy - May 1967 C.S. File 52/30-83

DECLINATION 14¼°E

Survey by Steven Ness, L.S. #811 - For: Weyerhaeuser Co. - Oct. 1995 - M 123-3 A & B

~~HAS PUNCH DOWN NEAR CENTER~~

Found - 1 3/4" unmarked steel cap on 1 1/4" Iron post. PROT. 4"
 35" D. Fir stump, N.85°07' E., 33.2 ft., face healed. NO NAIL ADDED
 Face has been sawn with a large wedge taken out.

BURNED ROTTEN 26" x 6 FT

BURNED AT BASE 34" 27" D. Fir

- ADD 3 1/2" MAG NAIL R.S.C.

MONUMENT IN MIXED OLD GROWTH AND REPROD. NEAR TOP OF
 EAST BANK OF SHALLOW SE RUNNING DRAW,
 CREEK ♀ IS S45°W ≈ 20 FT.

NEW REFS

BURNED AT BASE 22" D. FIR 3 1/2" MAG NAIL R.S.C. N02°W, 27 5

BURNED AT BASE 33" D. FIR 3 1/2" MAG NAIL R.S.C. N 14°E, 34 5

OGRS CANYONVILLE COTTAGE GROVE COORDS
 212501.091 N
 286083.281 E

CS 67/58-7 1/3