

GOVERNMENT CORNER RESTORATION FORM

FILED

TOWNSHIP 255 RANGE 1W SEC. 18

PLSS # 100460

Date: 6/10/2024 By: SC
This survey consists of:

DOUGLAS COUNTY OREGON

DATE 5/30/24

Map: _____

Narrative: _____

Corner Rpt: 67/58-8

Corner Designation

N 1/16 S 18 only
West LINE

DOUGLAS COUNTY
SURVEYOR

Monument(s) Found: (Condition and Source)

3/4" BLM BRASS CAP
proj 1"

___ Condition report

___ Not Found

Renewed

___ Unrecorded

___ Surveyed In

Previous Renewals

Established By BLM
Resurvey Vol 42 pg 16335
1978

Resurvey by BLM
Vol 53 Pg 20685

MONUMENT DETAIL

N 1/16
S 18
1978

Accessories Found

BURNED - DEAD 17" I. CEDAR N 78 1/2° E 35.3 FT
Fully Healed Single BLNZE ADD 3 1/2" MAG
NAIL RIGHT SIDE CENTER

BURNED - DEAD 18" I. CEDAR S 28 1/4° E
71.3 (Rec Dist. Not Checked due To Blowdown)
Fully Healed Single BLNZE

Metal Fence Post South 0.5 FT

C.S. File 67/58-8

New Accessories

BURNED- DEAD 13" D. Fire S27°W 12.8 FT
3 1/2" NING NAIL RIGHT Side Center

Sketch of Monument, Accessories, and General Area

Location & Comments


OCRS COORDINATE SYSTEM
Cottage Grove - Canyonville
Zone

N 208489.513
E 286124.411

MON. ON STEEP
WEST Slope 250'±
EAST OF N-S. DRAW
BOTTOM IN BURNED
Reprod

AREA BURNED
9-2020

Comp. Decline. 14 1/2° E
Agency DCSD
Party Chief S. F. HAUSE
Note keeper
Witnesses J. LORSHING

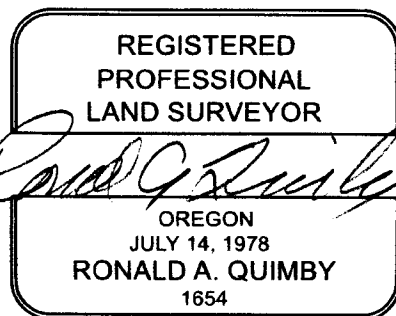

EXPIRES: 12/31/2024

CS 67/58-8

2/3

Dependent Resurvey of a Portion of the West Boundary,
T. 25 S., R. 1 W., Willamette Meridian, Oregon

CHAINS																						
	<p>A boulder in place, 5 x 4 x 3 ft. above ground, bears S. 50½° W., 23 lks. dist., mkd. XBO on top.</p>																					
	<p>N. 0° 12' 58" W., on the E. bdy. of sec. 12.</p>																					
	<p>Ascend steep SW. slope</p>																					
<p>13.400</p>	<p>The N 1/16 sec. cor. of sec. 18. only, monumented with an iron post, 2½ ins. diam., firmly set, projecting 1 in. above ground, with brass cap mkd.</p>																					
<p>OCRS CANYONVILLE COTTAGE GROVE CORDS 208489.513 N 286124.411 E</p>	<p>N 1/16 ✓ PROT. 1 INCH S18 1978</p> <p>RENEWED 5/30/24 DECLINATION 14¼° E FOUND METAL FENCE POST SOUTH ≈ 0.5 FT.</p>																					
	<p>from which bearing trees mkd. by Jelley</p>																					
<p>BURNED DEAD</p>	<p>17" I. cedar, 9 ins. diam., bears N. 78½° E., 53½ lks. dist., with a healed blaze. FHSB</p>																					
<p>" "</p>	<p>18" I. cedar, 12 ins. diam., bears S. 28¾° E., 108 lks. dist., with a healed blaze. (Record, 103 lks.) FHSB</p>																					
<p>33.25</p>	<p>Graveled road, 30 lks. wide, bears S. 75° E. and N. 65° W.</p>																					
<p>33.718</p>	<p>The closing cor. of secs. 7 and 18, perpetuated by Gary Langlitz, Deputy County Surveyor, in 1978, recorded in the Douglas County Surveyor's Office, <u>Record of Government Corners Renewed</u>, T. 25 S., R. 1 W., No. 136, monumented with an iron post, 2 ins. diam., firmly set, projecting 6 ins. above ground, with brass cap mkd.</p>																					
<p>MON. ON STEEP WEST SLOPE ≈ 250 FT. EAST FROM N-S RUNNING DRAW BOTTOM, AND IN BURNED REPROD.</p>	<p>NEW REF. - BURNED DEAD 13" D. FIR 3½" MAGNAIL RSC, S27°W, 12.8 FT.</p> <table border="0" style="margin-left: auto; margin-right: auto;"> <tr> <td></td> <td>T25S</td> <td></td> </tr> <tr> <td></td> <td>S 7</td> <td></td> </tr> <tr> <td>S 12</td> <td>CC</td> <td></td> </tr> <tr> <td></td> <td>S 18</td> <td></td> </tr> <tr> <td></td> <td>R 1 W</td> <td></td> </tr> <tr> <td></td> <td>CS 1978</td> <td></td> </tr> <tr> <td></td> <td>1957</td> <td></td> </tr> </table> <p>from which the remains of a bearing tree mkd. by V.W. Hosford, Registered Land Surveyor No. 253, in 1950</p> <p>A roothole, bears N. 70¾° E., 13 lks. dist., with fallen fir trunk, 17 ins. diam., lying alongside, with a healed blaze. (Record, N. 78° E., 17 lks.)</p> <p>and the remains of a bearing tree mkd. by Roseberry</p>		T25S			S 7		S 12	CC			S 18			R 1 W			CS 1978			1957	
	T25S																					
	S 7																					
S 12	CC																					
	S 18																					
	R 1 W																					
	CS 1978																					
	1957																					