

GOVERNMENT CORNER RESTORATION FORM

TOWNSHIP 25S RANGE 1W SEC. 18 PLSS # 114500

FILED
Date: 6/12/2024 By: SC
This survey consists of:

DOUGLAS COUNTY OREGON

DATE 6-11-24

Map: _____

Narrative: _____

Corner Rpt: CS 67/58-9

Corner Designation

Lot COR

L18	L19
L3	L2

⁵⁷ (80%₁₆ cor)

DOUGLAS COUNTY SURVEYOR

Monument(s) Found: (Condition and Source)

3/4" GLD BRASS CAP ON
Iron Pipe 4p 13"
ADD ROUGH MOUND OF STONE

___ Condition report

___ Not Found

Renewed

___ Unrecorded

___ Surveyed In

Previous Renewals

BLM 1957 Vol 12 pg 12141
Set mon.

BLM Resurvey 1999 Vol 53
pg 20701

MONUMENT DETAIL

57

L18	L19
L3	L2

518
1957

Accessories Found

None

New Accessories

BURNED - DEAD 9" D. FIR S 46° E 4.9 FT
3 1/2" MAG NAIL RIGHT SIDE CENTER

BURNED BASE - LIVE TOP 13 D. FIR
N 34° W 4.6 FT 3 1/2" MAG NAIL RIGHT
SIDE CENTER

Sketch of Monument, Accessories, and General Area


Location & Comments

OCRS COORDINATE SYSTEM
COTTAGE GROVE - CANYONVILLE
ZONE

MON ON STEEP
WEST SLOPE IN
BURNED SECOND
SECOND GROWTH

N 209892.791
E 289656.440

AREA BURNED
9/2020
Comp. Decline. 14 1/2° E
Agency DCSO
Party Chief S. F. HAUSE
Note keeper
Witnesses J. LORSUNG

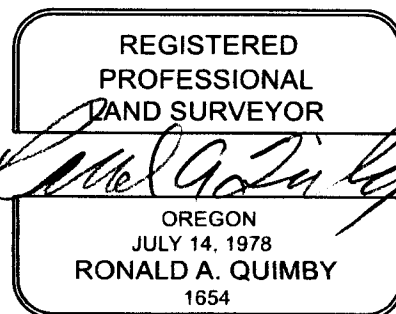

EXPIRES: 12/31/2024

CS 67/58-9 2/4

County Surveyor's Record, Douglas County, Oregon

Dependent Resurvey of Line bet. Secs. 7 and 18, T. 25 S., R. 1 W.

CHAINS

Set an iron post, 36 ins. long, 2 ins. diam., 28 ins. in the ground, with brass cap marked

T25S R1W

$\frac{1}{4} \frac{S 7}{S 18}$

1957

from which

A fir, 30 ins. diam., bears N. 1° E., 39 lks. dist., marked $\frac{1}{4}$ S7 BT.

A hemlock, 7 ins. diam., bears S. 39½° W., 133 lks. dist., marked $\frac{1}{4}$ S18 BT.

Descend 76 ft. along N. slope.

44.80 Foot of descent, slopes N.; ascend 128 ft. along N. slope.

50.08 Spur, slopes NW.; descend 312 ft. over steep W. slope.

57.56 Spring branch, 2 lks. wide, course NW.; ascend 22 ft. along N. slope.

58.08 Point for the cor. of lots. 1, 2, 19 and 20.

Set an iron post, 36 ins. long, 2 ins. diam., 28 ins. in the ground, in a mound of stone, 3 ft. base, to top, with brass cap marked

$\frac{S 7}{L 19 | L 20}$
 $\frac{L 2 | L 1}{S 18}$
1957

Ascend 41 ft. along steep N. slope.

61.30 Spur, slopes NW.; descend 501 ft. over W. slope.

73.20 Branch, 2 lks. wide, course NW.; descend 55 ft. along N. slope.

77.44 Point for the cor. of lots. 2, 3, 18 and 19.

Set an iron post, 36 ins. long, 2 ins. diam., 27 ins. in the ground, in a mound of stone, 2 ft. base, to top, with brass cap marked

$\frac{S 7}{L 18 | L 19}$
 $\frac{L 3 | L 2}{S 18}$
1957

Descend 147 ft. along N. slope changing to NW. slope.

82.37 North Fork of the East Fork of Rock Creek, 40 lks. wide, 1 ft. deep, course S. 50° W.; ascend 300 ft. over SE. slope.

83.14 Gravelled access road, 35 lks. wide, bears N. 10° E. and S. 10° W.

93.50 Spring seepage, course SE.; ascend 60 ft. over SE. slope.

96.80 A maple post, 3 ins. square, protruding 36 ins. above ground, firmly set, in a mound of stone, 3 ft. base, 1 ft. high, marked lot cor. lots 3, 4, 17 and 18; ascend 30 ft. along rocky S. slope.

104.00 Spring branch, 1 lk. wide, course SE.; ascend 411 ft. over E. slope.

116.16 Point for the cor. of lots 4, 5, 16 and 17.

114500



CS 67/58-9 314

1/0/53 20701 20701

Dependent Resurvey of a Portion of the Subdivisional Lines
T. 25 S., R. 1 W., Willamette Meridian, Oregon

12/40
M/59-39

CHAINS										
	Continue desc. over broken NW. slope. 120900									
19.392	The W 1/16 sec. cor. of secs. 7 and 18, monumented with an iron post, 2 ins. diam., firmly set, projecting 12 ins. above ground, with brass cap mid.									
	<div style="text-align: center;"> <p>S 7</p> <table border="0"> <tr><td>L19</td><td> </td><td>L20</td></tr> <tr><td>L2</td><td> </td><td>L1</td></tr> <tr><td>S18</td><td></td><td></td></tr> </table> <p>1957</p> </div>	L19		L20	L2		L1	S18		
L19		L20								
L2		L1								
S18										
	from which a new bearing tree									
	A hemlock, 9 ins. diam., bears N. 48° W., 8 lks. dist., mkd. L19 S7 BT.									
	S. 89° 22' 08" W., beginning new measurement.									
	Continue desc. over broken NW. slope.									
19.427	The 80 1/16 sec. cor. of secs. 7 and 18, monumented with an iron post, 2 ins. diam., firmly set, projecting 14 ins. above ground, with brass cap mkd.									
NORTH LINE S18	<div style="text-align: center;"> <p>S 7</p> <table border="0"> <tr><td>L18</td><td> </td><td>L19</td></tr> <tr><td>L3</td><td> </td><td>L2</td></tr> <tr><td>S18</td><td></td><td></td></tr> </table> <p>1957</p> </div>	L18		L19	L3		L2	S18		
L18		L19								
L3		L2								
S18										
	No new accessories available.									
	S. 89° 27' 51" W., beginning new measurement.									
	Continue desc. over broken NW. slope.									
2.00	Graveled road, 25 lks. wide, bears N. 47° E. and S. 47° W.									
4.40	North Fork of East Fork Rock Creek, 40 lks. wide, course S. 40° W.; asc. over broken SE. slope.									
5.65	Asphalt road, 60 lks. wide, bears N. 25° E. and S. 36° W.									

MINI GIS
43.40818
122.86001

MON. ON STEEP WEST SLOPE
IN BURNED SECOND GROWTH TIMBER

RENEWED 6/11/24
DECLINATION 14 1/4° E
3 1/4" GLO CAP PROT. 13"
ADD ROUGH MOUND OF STONE

OAKS CANYONVILLE COTTAGE GROVE COORDS
209892.791N, 289656.440E

NEW REFS

BURNED DEAD 9" D. FIR 3 1/2" MAG NAIL RSC S 46° E, 49 FT.
" LIVE TOP 13" " " " " N 34° W, 46 FT.
CS 67/58-9, 414