

GOVERNMENT CORNER RESTORATION FORM

TOWNSHIP 255 RANGE 1W SEC. 30 PLSS # 140240

FILED  
Date: 7/9/2024 By: X  
This survey consists of:

DOUGLAS COUNTY OREGON

DATE 6-13-24

Map: \_\_\_\_\_  
Narrative: \_\_\_\_\_  
Corner Rpt: CS 67/58-10

Corner Designation

C 1/4 530

DOUGLAS COUNTY  
SURVEYOR

Monument(s) Found: (Condition and Source)

3" BRASS CAP ON  
2 1/2" O.D. IRON PIPE UP  
6" IN LARGE ROUGH STONE MOUND

- Condition report
- Not Found
- Renewed
- Unrecorded
- Surveyed In

Previous Renewals

Established by L. Friar  
April 1979 in 70-70

MONUMENT DETAIL

T255 R1W  
C 1/4 530  
PLS 961  
1979

Accessories Found

BURNED Broken Rotted 6" X 5 1/2 FT FIR STUB  
N 40° 31' 14" E 13.3 FT BLAZES BURNED AWAY

BURNED Broken Rotted 5" X 3 1/2 FT FIR  
Stub S 0° 31' 14" E 12.3 FT ALL SCRIBES VISIBLE  
ON FIRE OPENED DOUBLE BLAZE

Both BT'S HAVE <sup>3/4"</sup> BRASS WASHER NAILED  
IN LOWER BLAZE STAMPED CS 961

Steel Fence Post North 4.0 FT WITH  
TWO U.S.F.S SURVEY MARKER SIGNS

~~NEW 3/4" BRASS WASHER, 3/4" NAIL~~  
~~3/4" BRASS WASHER, 3/4" NAIL~~

Add TO NEW ACCESSORIES  
SEE PG 2

New Accessories

From PGI

30" IR Proj 5" S40°E 5.5

30 IR Proj 5" N80°E 5.8

Sketch of Monument, Accessories, and General Area

Location & Comments

MON. NEAR TOP OF STEEP  
WESTERLY SLOPE APPROX. 50 FT  
WEST AND 20 FT LOWER THAN  
CREST OF SMALL NNE RIDGE

MON. IS 175 FT  
NORTH FROM SHARP  
CURVE IN GRAVEL  
ROAD

AREA BURNED  
9-2020


OURS COORDINATE SYSTEM  
COTTAGE GROVE CANYONVILLE  
ZONE

Comp. Decline. 1 1/4° E  
Agency DCSD  
Party Chief S. F. HAUSE  
Note keeper  
Witnesses J. LORESONG

N 196292.283

E 292626.435

and in burned  
younger reprod  
forest

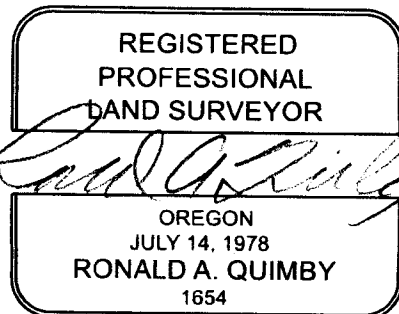

CS 67/58-10

23

6/13/24

TOWNSHIP 25 RANGE 01 POINT IDENTIFIER # 140240

PRIMARY CORNER DESCRIPTION Center 1/4 Cor. Sec. 30

Alias _____	Description _____
Alias _____	Description _____
Alias _____	Description _____
Alias _____	Description _____

DECLINATION 14° 4' E

Larry J. Friar - For: Umpqua National Forest - April 1979 - M 70-70

Set - 2 1/2" <sup>D.D.</sup> x 30" Gal. I. Pipe with 3" dia. brass cap stamped: **PROT. 6" HAS LARGE ROUGH MOUND OF STONE**  
T25S R1W C 1/4 + S30 PLS 961 1979

From which: **(BURNED, BROKEN, ROTTED 6" x 5 1/2 FT STUB) BLAZES BURNED AWAY**  
A 8" Fir bears N. 40 3/4° E, 13.3 ft. scribed ~~C 1/4 S30 BT.~~  
A 8" Fir bears S. 0 3/4° E, 12.3 ft. scribed C 1/4 S30 BT. **ALL VISIBLE, INTACT**  
**(BURNED, BROKEN, ROTTED 5" x 3 1/2 FT STUB) ON FIRE OPENED DOUBLE BLAZE**

**BOTH B.T.S HAVE A 3/4" BRASS WASHER ATTACHED BY A NAIL DRIVEN THROUGH CENTER. WASHER ARE IN LOWER BLAZE FACES. WASHERS ARE STAMPED "LS 961"**

**STEEL FENCE POST WITH TWO USFS SURVEY MARKER SIGNS, NORTH 4 FT.**

**MONUMENT NEAR TOP OF STEEP WESTERLY SLOPE AND APPROX. 50 FT. WEST FROM AND 20 FT. LOWER THAN CREST OF SMALL NNE RUNNING RIDGE. MONUMENT IS 175 FT. NORTH FROM SHARP CURVE IN GRAVEL RD. AND IN BURNED YOUNGER REPROD. FOREST.**

OCS CANYONVILLE COTTAGE GROVE COORD.S

196292.283 N

292626.435 E

CS 67/58-10  
3/3

43.7120  
122.84972