

GOVERNMENT CORNER RESTORATION FORM

FILED

TOWNSHIP 255 RANGE 2W SEC. 24 PLSS # 660320

Date: 7/9/2024 By: JC
This survey consists of:

DOUGLAS COUNTY OREGON

DATE 6-19-24

Map: _____

Narrative: _____

Corner Rpt: CS 67/58-12

Corner Designation

SE 1/16 S2A

DOUGLAS COUNTY
SURVEYOR

Monument(s) Found: (Condition and Source)

3/4" Iron pipe up 19"

___ Condition report

___ Not Found

Renewed

___ Unrecorded

___ Surveyed In

Previous Renewals

set by Hostford 1958 M 16-5
ECS 42/20

Wichesney 1975 CS 59/11-9
Edwards 2017 CS 65/95-38

MONUMENT DETAIL

Accessories Found

Very Burned Rotted 40" x 3 FT Cedar
Stump N 7° E 16.1 FT (Rec 13.7 To Face) DIST
To RIGHT Side Center

BURNED Rotted 14" x 4 1/2 FT Cedar Stump
N 72° E 26.9 FT (Rec N 74° E 25.9 DIST To Face)
DIST to RIGHT Side Center

BURNED Rotted 26" x 5 FT Cedar Stump
S 47 1/2° W 20.0 FT (Rec S 47 1/2° E 19.0 FT To Face)
DIST To RIGHT Side Center

BURNED Dead 6" Alder N 60° E 17.1 FT (Rec 16.9 FT)
PARTIAL Scribes Visible

BURNED Dead 14" D. FIR N 81° W 19.3 FT (Rec 19.1 FT)
Scribes Visible

C.S. File 67/58-12

1/4

Monument Set (Procedure and Description)

MONUMENT DETAIL

Blank lines for Monument Set description.

New Accessories

Blank lines for New Accessories description.

Sketch of Monument, Accessories, and General Area

Location & Comments


OCS Coordinate System
Cottage Grove - Canyonville
Zone

MON IS ON MOSTLY
FLAT STREAM BED
235' E EAST OF
GRAVE ROAD IN
LARGE CLEARCUT
AREA BURNT

N 198239.685

E 284662.487

9-2020
Comp. Decline. 14 1/4° E
Agency DCSO
Party Chief S. F. Hulse
Note keeper
Witnesses J. LORSUMBY

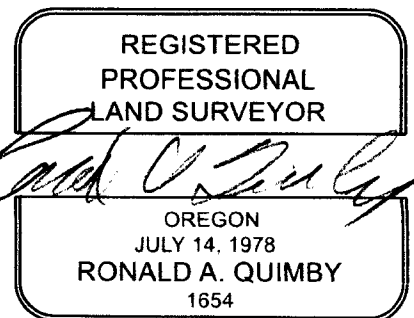

EXPIRES: 12/31/2024

CS 67/58-12

2/4

FILED

Date: 7-6-2017 By: JC

This survey consists of:

Map: _____

Narrative: _____

Corner Rpt: CS 65/95-38

DOUGLAS COUNTY
SURVEYOR

CORNER REPORT FORM

Section 24 Township 25 S Range 2 W
Douglas County Date May 8, 2017
PLSS Number 660320

CORNER DESIGNATION

SE 1/16 corner of Section 24.

- ___ Condition Report only
- ___ Not Found
- X Renewed
- ___ Unrecorded
- ___ Surveyed In
- ___ Referenced out

RENEWED 6/19/24

Previous Renewals/Surveys, etc.:

Set by Hosford on survey M 16-5. (Hemlock post)
Iron pipe set by Williams/McChesney in 1975. See C.S. 59/11-9.

DECLINATION 14 1/4° E

Monument(s) & Accessories Found: (Condition and Source)

PROT 19" - Found 3/4" diam. iron pipe from 1975.

All of the following found bearing trees are stumps with partial scribing visible.

A 4 1/2" Cedar stump bears N. 70° E., 43.7' to ~~the~~ nail in face. NAIL GONE MEAS. TO CRC

A 18" diam. Cedar stump bears N. 74° E., 25.9' to face. N 72° E, 26.9 TO CRC

A 33" diam. Cedar stump bears S. 47 1/2° E., 19.0' to face. W, 20.2 TO CRC

VERY BURNED ROTTED OUT 40" X 3 FT STUMP

BURNED SOME WHAT ROTTED 26" X 5 FT. STUMP

BURNED ROTTED 14" X 4 1/2" STUMP BLZ. GONE

Monument Detail

Sketch

N/A

MONUMENT IS ON MOSTLY FLAT STREAM BED ≈ 235 FT. EAST FROM GRAVEL RD.
SURROUNDED BY LARGE CLEARCUT

OGRS CANYONVILLE COTTAGE GROVE COORD. S

198239.685 N 284662.487 E

Monument Set (Procedures and Description)

N/A

New Accessories

A 6" diam. Alder bears N. 60° E., 16.9' to center of tree at root crown.

A 14" diam. Fir bears N. 81° W., 19.7' to center of tree at root crown.

Both are scribed "SE 1/16 S24 BT" A six foot steel post is set 2 feet North.

BURNED PHS BALL SCR BG. VIS 193

Surveyor's Seal

Location & Comments

Compass Declination 15° East

Firm/Agency: David Edwards Land Surveying


Address: P.O. Box 361

Oakland, Oregon 97462

Party Chief: Brant Miller

Notes: _____

Witness: Eric Sprinkle

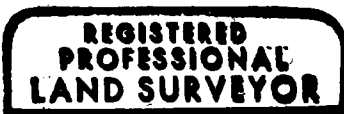

David A. Edwards



Renews 12/31/17

C.S. File 65/95-38

CS 67/58-12 3/4

TOWNSHIP 25 RANGE 02 POINT IDENTIFIER # 660320

PRIMARY CORNER DESCRIPTION SE 1/16 Cor Sec 24

Alias _____	Description _____
Alias _____	Description _____
Alias _____	Description _____
Alias _____	Description _____

V.H. Hosford - Evans Products Co. - Sept. 1955 - M16-5 & C.S.
File 42/20

Set - A 4" hemlock post marked S E 1/16 S 24., from which;
 A cedar 14" in dia. bears N.74°E. 25.9 ft. marked 1/16
 S 24 P.S. 253 BT.
 A cedar 30" in dia. bears S.47½°E. 19.0 ft. marked 1/16
 S 24 P.S. 253 B.T.

Frank O. Williams, Glen McChensney - For: Weyerhaeuser Co. -
Feb. 26, 1975 - C.S. 59/11-9

Found - Hosford's BTs a 14" Cedar, now 16", scribing visible
 N.74°E., 25.9 ft. to face.
 A 30" Cedar scribing visible, S.48°W, (Rec.
 S.47½°E.), 19.0 ft. (*Please note bearing is SW
 instead of SE) *added 5/10/2017 JC

Set - 3/4" Pipe by Hosford's *called distances & recorded
 bearings as shown.
 38" Cedar, N.07°E., 13.7 ft. with "W" nail & plate.

MINI GIS
43.57646
122.87089

CS 67/58-12 414