

GOVERNMENT CORNER RESTORATION FORM

TOWNSHIP 256 RANGE 2W SEC. 24

PLSS # 620340

FILED  
Date: 7/9/2024 By: JC

This survey consists of:

Map: \_\_\_\_\_

DOUGLAS COUNTY OREGON

DATE 6-19-24

Narrative: \_\_\_\_\_

Corner Rpt: CS 67/58-13

Corner Designation

CW 1/16

DOUGLAS COUNTY  
SURVEYOR

Monument(s) Found: (Condition and Source)

2 1/2" Alum Cap Roseburg  
Resources M 176-59

\_\_\_ Condition report

\_\_\_ Not Found

Renewed

\_\_\_ Unrecorded

\_\_\_ Surveyed In

Previous Renewals

Hosford 1957 M 16-5 CS 42/20  
EDWARDS 2020 M 176-59

MONUMENT DETAIL

T 256 R 2W

CW 1/16

S 24

LS 2339

2020

Accessories Found

11" D. Fir N 3° E 6.1 FT

6' Steel post 2.0 FT North

Monument Set (Procedure and Description)

MONUMENT DETAIL

---



---



New Accessories

15" X 2' FT FIR Stump S56°W 16.0 FT  
 MAG NAIL TOP CENTER

---



---



Sketch of Monument, Accessories, and General Area

Location & Comments

OCRS COORDINATE System  
 Cottage Grove - Canyonville  
 Zone

---



---




---



---

N. 199685.725  
 E 282254.048

Comp. Decline. 14 1/4° E  
 Agency DCSO  
 Party Chief S. FRAUSE  
 Note keeper \_\_\_\_\_  
 Witnesses J Zorsung

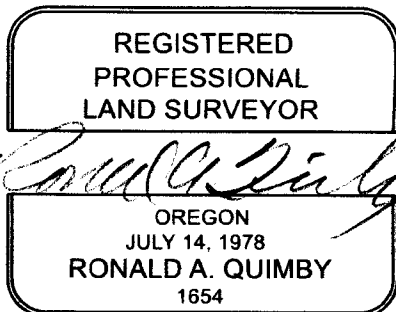

EXPIRES: 12/31/2024

CS 67/58-13 2/3

