

GOVERNMENT CORNER RESTORATION FORM

FILED

TOWNSHIP 255 RANGE 2W SEC. 13

PLSS # 620406

Date: 7/9/2024 By: SC
This survey consists of:

DOUGLAS COUNTY OREGON

DATE 6-20-24

Map: _____

Narrative: _____

Corner Rpt: CS 67/58-15

Corner Designation

W 1/16 13/24

DOUGLAS COUNTY
SURVEYOR

Monument(s) Found: (Condition and Source)

3/4" BRASS CAP IN
Rough Stone Mound up
10"

___ Condition report

___ Not Found

Renewed

___ Unrecorded

___ Surveyed In

Previous Renewals

Hosford 1953 M 16-5 &
CS 42/20
BLM Resurvey 2002
Vol 54 pg 20913

MONUMENT DETAIL

+255R2W
W 1/16 513
524
2002

Accessories Found

BURNED - DEND 24" D. KIR N30°E 21.0 FT
(Rec 20.8 FT) ADD 3 1/2" N1A9 N1A1
RIGHT SIDE CENTER
BURNED out SHATTERED 16" X 6 FT D. FIRE
STUMP S60°E 7.7 FT BARK SCOR ONLY
CENTER GORE

C.S. File 67/58-15

Monument Set (Procedure and Description)

MONUMENT DETAIL

New Accessories

10" X 20 FT BURNED FIR SNAG N 63° E
 12.5 FT 3 1/2" MAG NAIL RIGHT SIDE
 Center

Sketch of Monument, Accessories, and General Area

Location & Comments

MON. IS 175 FT ± NORTH OF
 GRAVEL ROAD


MON ON Steep West
 Slope Old Second
 Growth N.E. QUAD
 Rest Clearcut

OCRS Coordinate System
 Cottage Grove - Canyonville
 Zone


AREA Burnt
 9/2020
 Comp. Decline. 14 1/2° E
 Agency OCSO
 Party Chief S. F. HUSE
 Note keeper
 Witnesses J. LORSUNG

N 202378.992

E 282217.077

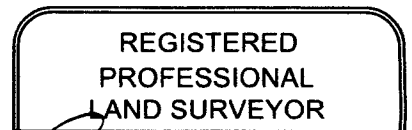

Ronald A. Quimby

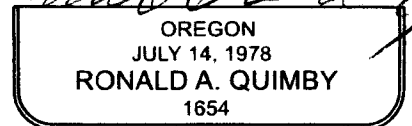

EXPIRES: 12/31/2024

CS 67/58-15

Dependent Resurvey of a Portion of the Subdivisional Lines,
T. 25 S., R. 2 W., Willamette Meridian, Oregon

FEET	
	from which the remains of the original bearing trees
	A sawed, decayed fir stump, 30 ins. diam., bears S. 67 $\frac{1}{2}$ ° E., 15.8 ft. dist., with healed blaze. (Record, S. 58° E.)
	A fir, 55 ins. diam., bears N. 13° W., 7.9 ft. dist., with healed blaze. (Record, N. 25° W.)
	and remains of bearing trees mkd. by Brooks
	A sawed fir stump, 12 ins. diam., bears S. 49 $\frac{1}{2}$ ° W., 20.8 ft. dist., with a healed blaze. (Record, S. 48 $\frac{1}{2}$ ° W., 21.8 ft.)
	A cedar, 16 ins. diam., bears N. 38 $\frac{1}{2}$ ° W., 12.9 ft. dist., with a healed blaze. (Record, N. 41° W., 12.2 ft.)
	and new bearing tree
	A fir, 13 ins. diam., bears S. 78 $\frac{1}{2}$ ° W., 37.7 ft. dist., mkd. 1/4 S24 BT.
	<p style="text-align: center;">OCCRS CANYONVILLE COTTAGE GROVE CORP'S 202378.992 N FOR 620400 282217.077E</p>
	DECLINATION 14 $\frac{1}{4}$ ° E RENEWED 6/20/24
	N. 89° 06' 28" W., beginning new measurement, continue posting and blazing. MONUMENT ON STEEP WEST SLOPE, OLD SECOND GROWTH
	Ascend NE. slope. NE QUAD, REST CLEARCUT
	~ 175 FT. NORTH OF GRAVEL RD.
875	Spur, slopes N. 17° E.; desc. broken NW. slope.
1145	Gravel road, 20 ft. wide, bears N. 13° E. and S. 20° W.
1321.59	The W 1/16 sec. cor. of secs. 13 and 24, established by V.W. Hosford, Oregon Registered Land Surveyor No. 253, in 1953, recorded in the Douglas County Surveyor's Office, C.S. File Nos. 41/245A and 41/245b, and is accepted as the cor., determined at Hosford record bearing and distance from his bearing trees
	BURNED DEAD 24" D. FIR - A fir, 19 ins. diam., bears N. 30° E., 20.8 ft. dist., with healed blaze. ✓ ADD 3 $\frac{1}{2}$ " MAG NAIL R.S.C.
	BURNED OUT SHATTERED - A fir, 20 ins. diam., bears S. 6° E., 7.7 ft. dist., with healed blaze. BARK SCAR ONLY
	At the corner point
	Set an iron post, 28 ins. long, 2 $\frac{1}{2}$ ins. diam., 16 ins. in the ground, in a mound of stone, 3 ft. base, to top, with brass cap mkd. T25S R2W PROT. 10" SURROUNDED BY ROUGH MOUND OF STONE
	3 $\frac{1}{4}$ " B.C. W 1/16 S13 524
	2002 CS 67/58-15 3/3

MINI GIS
43.38777
122.88886

NEW REF. 10" X 20 FT BURNED FIR SNAG N63° E, 125
WITH 3 $\frac{1}{2}$ " MAG NAIL R.S.C.