

GOVERNMENT CORNER RESTORATION FORM

FILED

TOWNSHIP 25S RANGE 2W SEC. 24 PLSS # 420320

Date: 7/9/2024 By: JC
This survey consists of:

DOUGLAS COUNTY OREGON

DATE 6-20-24

Map: _____

Narrative: _____

Corner Rpt: CS 67/58-16

Corner Designation

S.W 1/16 S 24

DOUGLAS COUNTY
SURVEYOR

Monument(s) Found: (Condition and Source)

___ Condition report

BURNED SAWN 22" X 2 1/2'
Solid Cedar stump NO MARKS
Visible 2 1/2" B.C IN CENTER

___ Not Found

Renewed

Previous Renewals NO RECORD

___ Unrecorded

___ Surveyed In

Set by Hostford M 16-5
1955

MONUMENT DETAIL

McChesney 5-20-58
CS 53/112-36 & CS 42/20

SW 1/16
S 24
LS 2339
2017

Accessories Found

BURNED Rotted 30" X 2 1/2 FT Hemlock stump
N 76° E 23.2 FT Scribe S 24 Visible

BURNED SAWN 21" X 2 FT Hemlock stump
S 53° W 36.4 FT ORIG. FACE Visible inside

BURNED - Rotted 34" X 3 1/2 FT FIR stump
S 20° E 22.4 FT (Rec S 24° E 22.0 FT) TO NAIL
IN FACE ADD 3 1/2" MAG NAIL TO FACE

C.S. File 67/58-16

New Accessories

BURNED SAWN 27" X 1 1/2 FT Hemlock
 Stump S72°W 12.3 FT 3 1/2" MAG NAIL
 Top Center


Sketch of Monument, Accessories, and General Area

Location & Comments

OCRS Coordinate System
 Cottage Grove - Canyonville
 Zone

N 198421.038
 E 282217.140

Comp. Decline. 14 1/2° E
 Agency DCSO
 Party Chief S. K. WISE
 Note keeper
 Witnesses J. LORSUNG

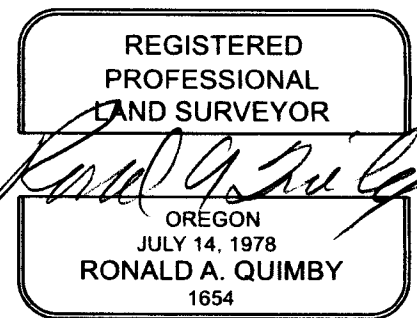

EXPIRES: 12/31/2024

CS 67/58-16 2/5


I Spoke with David Edwards, He said they did not use the corner for their map, but his guys were there and found the OBT's. They had no records of setting the cap. We agreed to just write it up as a previously unrecorded accessory.

CS 67/58-16
3/5

PUBLIC LAND CORNERS

WEYERHAEUSER TIMBER COMPANY
 SPRINGFIELD BRANCH

TOWNSHIP 25 S RANGE 2 W
 SECTION 24 CORNER L 1/16
 COUNTY Douglas OREGON

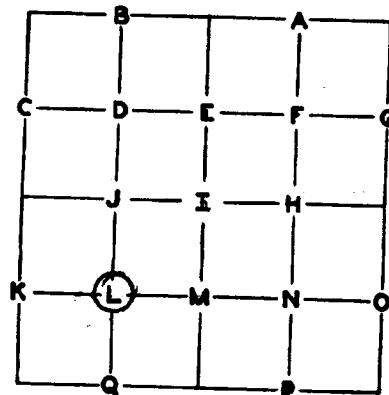

RENEWED 6/20/24

GLO SURVEY RECORD

DATE: _____
 CORNER _____

PRESENT CONDITION - (DESCRIBE FULLY -
 USE PAGE 2 IF NEEDED FOR EXPLANATION.)

DECLINATION $14\frac{1}{4}^{\circ} E$

ACCESSORIES:

BEARING-	LINKS-	FEET-

BURNED, SAWN BUT SOLID CEDAR STUMP
 22" x 2 1/2 FT TALL, NO SCRIBING REMAINS
 FOUND A DAVID EDWARDS 2 1/2" B.C.
 SET INTO CENTER OF STUMP
 CAP MARKED "SW 1/16"

S24
 L52339

PRESENT CONDITION: 2017

Found Scribed on four Sides
 Found Scribed
 Found Scribed

Hosford SURVEY RECORD
 DATE: 1957
 Corner: 28" Cedar Tree.

20" Hem. N76E 22.4 SEE BELOW
 12" Hem S53W 35.5 SEE BELOW

CORNER SET: 28" Cedar Tree - Hosford Survey MAG. DECL: 20°

ORIG. FACE MEAS.

BEARING AND DISTANCE TO ABOVE IDENTIFIED SURVEY ACCESSORIES:

BEARING-	FEET-	SURVEY-	
N76°E	22.4	Hosford	20" Hemlock LIGHTLY BURNED ROTTED STUMP 30" x 2 1/2 FT SCRIBING "S24 VISIBLE" N76°E 23.2 TO C.R.C.
S53°W	35.5 TO ORIG FACE)	12" Hemlock LIGHTLY BURNED SAWN STUMP 31" x 2 FT ORIG FACE VISIBLE INSIDE S53°W, 36 1/2 TO C.R.C.
(GO TO PG. 3)			
CS 53/112-36 CS 67/58-16 4/5			

ACCESSORIES ADDED THIS DATE:

MAGNETIC DECLINATION 20°

	BEARING	FEET	ORIG. SET	"W" NAIL	PLATE	BRASS DISC
20" Hem <u>SEE PG. 1</u>	N76°E	FACE 22.7	Hasford	X	X	
40" Fir <u>LIGHTLY BURNED AND ROTTED FIRST STUMP</u>	S24°E S20°E	22.0 22.4		X	X	
<u>34" x 3 1/2 FT.</u>	TO NAIL IN FACE					

ADD 3 1/2" MAG NAIL TO FACE

IDENTIFIED ON PHOTO:

INFORMATION ON LOCATION OF CORNER AS NOW SET: OCRS CANYONVILLE COTTAGE GROVE COORDS

GROUND COVER: Rhododendron, Oregon Grape 198421.038 N

(USING FORM LINES SKETCH TOPOG AT CORNER ON PAGE 2 PLAT) 282217.140 E

SLOPE FACES (GIVE BEARING IN DEGREES) West ON MINUS (-) 28 %

NEW REFERENCE: BURNED AND SAWN HEMLOCK STUMP SET 3 1/2" MAG NAIL TOP CENTER
S72°W, 12 3 FT. DIST

NORTH: +10% Through old growth.

SOUTH: -10%. Logged to West, old growth to East

EAST: +20% through old growth.

WEST: -28%. Logged to South, old growth to North. Approx. 990' to dirt road.

WORK DONE FOR W. T. CO.:

FIELD NOTES IN BOOK: _____

BY: Glen McCreaney
ENGINEER - SURVEYOR

DATE: 5/20/58

UNDER THE SUPERVISION OF:

ASSISTED BY: _____

COPIES SENT TO: _____

CS 67/58 - 16
5/5

SEAL