

GOVERNMENT CORNER RESTORATION FORM

FILED

TOWNSHIP 25S RANGE 3W SEC. 23 PLSS # 600340

Date: 7/10/2024 By: X  
This survey consists of:

DOUGLAS COUNTY OREGON

DATE 7-1-24

Map: \_\_\_\_\_  
Narrative: \_\_\_\_\_  
Corner Rpt: CS 67/58-20

Corner Designation

1/4 COR S23/S24

DOUGLAS COUNTY  
SURVEYOR

Monument(s) Found: (Condition and Source)

GLO BRASS CAP

- Condition report
- Not Found
- Renewed
- Unrecorded
- Surveyed In

Previous Renewals

GLO Resurvey 1940 Vol 27

pgs 11544-45

DCSO 1966 CS 54/7-62

BLM Resurvey 1990-91 Vol

51 pgs 19257-58

EDWARDS 1993 M 151-74

BLM Resurvey 2008 Vol 57 pgs 22423-4

DCSO 2020 67/046-03.6

Accessories Found

MONUMENT DETAIL

1/4  
S23/S24  
1943

A SAWN decayed FIRE Stump 15"  
N55°E 141.2 FT

A SAWN Hemlock Stump 18" S37°W  
70.6 FT partly healed BLAZE with metal  
CAP

A 17" FIRE S50°E 10.2 FT with healed  
BLAZE

A 8" FIRE S82°W 16.5 FT with healed  
BLAZE

Side spikes still there (2020 DCSO renewal) new tags,  
flagging

C.S. File 67/58-20

RENEWAL

Monument Set (Procedure and Description)

MONUMENT DETAIL

---



---



New Accessories

---



---



Sketch of Monument, Accessories, and General Area

Location & Comments


OCRS COORDINATE SYSTEM  
Cottage Grove - Canyonville  
Zone

AREA BUNDLES  
9-2020

N 198271.058

E 249334.116

Comp. Decline. 14 1/2° E  
Agency DCSO  
Party Chief J. Loring  
Note keeper  
Witnesses

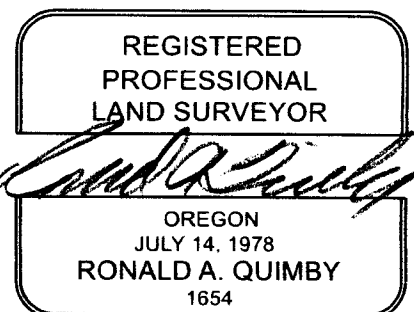

EXPIRES: 12/31/2024

CS 67/58-20 2/3

MMGPS TIME - 11:50 7-1-21  
H.I. - 2.000M

TOWNSHIP 25 RANGE 03 POINT IDENTIFIER # 600340

PRIMARY CORNER DESCRIPTION 1/4 Cor. Secs. 23 & 24

Alias _____	Description _____
Alias _____	Description _____
Alias _____	Description _____
Alias _____	Description _____

from which the remains of the original bearing trees

A roothole bears N.20°E., 17.8 ft., alongside of which is an uprooted, sawed, decayed fir stump, 60" dia., with fragmentary scribe marks visible on a partially healed blaze.

A sawed fir stump, 36" dia., bears S.65°W., 48.8 ft., with scribe marks 23 visible on a partially healed blaze, with a metal cover.

and the remains of bearing trees mkd. by the Douglas County Surveyors Office in 1966, reported by Bedell

✓ A sawed, decayed fir stump, 15" dia., bears N.55°E., 141.2 ft., with fragmentary scribe marks visible on a partially healed blaze.

✓ A sawed hemlock stump, 18" dia., bears S.37°W., 70.6 ft., with fragmentary scribe marks visible on a partially healed blaze, with a metal cover.

and bearing trees mkd. by Bedell

✓ A fir, 17" dia., bears S.50°E., 10.2 ft., with a healed blaze.

✓ A fir, 8" dia., bears S.82°W., 16.5 ft., with a healed blaze.

and the remains of a bearing tree mkd. by person(s) unknown

✓ A sawed, decayed fir stump, 48" dia., bears N.31½°W., 55.2 ft., with a healed blaze and Weyerhaeuser aluminum

bearing tree tag mkd. W.T. CO. Sec. 23 TWP 25 S. R. 8 W. 54.5 FT. S 31 E TO E ¼ COR.

Corner is located on a gradual S. slope.

Fd. OK by DCSO: Stephen Flause & Jeff Lorsung 7-7-2020 - C.S.

~~File # 67/58-20-3/3~~



SIDE SPIKES STILL THERE, NEW TAGS, FLAGGING  
+ OCRS POSITION

CS 67/58-20

3/3