

GOVERNMENT CORNER RESTORATION FORM

FILED

TOWNSHIP 255 RANGE 2W SEC. 11

PLSS # 600540

Date: 7/10/2024 By: X

This survey consists of:

DOUGLAS COUNTY OREGON

DATE 7-1-24

Map: _____

Narrative: _____

Corner Rpt: CS67/58-21

Corner Designation

1/4 11/12

DOUGLAS COUNTY SURVEYOR

Monument(s) Found: (Condition and Source)

BLM BRASS CAP

___ Condition report

___ Not Found

Renewed

___ Unrecorded

___ Surveyed In

Previous Renewals

Hosford 1957 CS 42/308-11

Mc Chesney 1970 CS 53/112-18

Ness 1995 M122-3A & B

BLM RESURVEY 2001-2002

Vol 54 pgs 20935-9

MONUMENT DETAIL

T255 R2W

1/4

S11 | S12

2001

Accessories Found

26" X 4" I. CEDAR S 7 1/4 W 81.6 FT
(Rec 81.2 FT) ADD 3 1/2" MAG NAIL TOP
CENTER

23" D. FIR S 7 1/4 W 25.2 FT (Rec 25.1 FT)
HEATED DOUBLE BLAZE ADD 3 1/2" MAG NAIL
RIGHT SIDE CENTER

22" D. FIR N 66 1/2 W 38.1 FT HEATED
DOUBLE BLAZE ADD 3 1/2" MAG NAIL
RIGHT SIDE CENTER

Steel Post 1 FT EAST

C.S. File 67/58-21

1/4

RENEWAL

Monument Set (Procedure and Description)

MONUMENT DETAIL

New Accessories

13" I. CEDAR S 40°W 24.3 FT
 3 1/2" MAG NAIL RIGHT side Center

Sketch of Monument, Accessories, and General Area


Location & Comments

OCRS Coordinate System
 Cottage Grove - Canyonville
 zone

AREA BURNT
 9/2020

N 210270.846
 E 280650.476

Comp. Decline. 14 1/4° E
 Agency DCSO
 Party Chief J. Lorusung
 Note keeper
 Witnesses

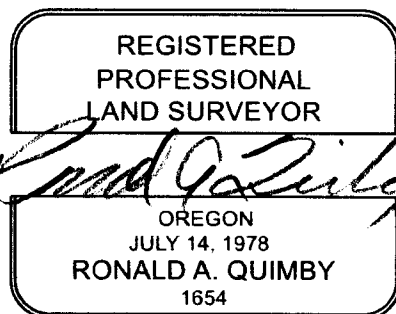

EXPIRES: 12/31/2024

CS 67/58-21 214

TOWNSHIP 25 RANGE 02 POINT IDENTIFIER # 600540

PRIMARY CORNER DESCRIPTION 1/4 Cor. Secs. 11 & 12

Alias _____ Description _____
Alias _____ Description _____
Alias _____ Description _____
Alias _____ Description _____

GLO Survey by Hezikiah H. Johnson, under Contract #721, dated May 1, 1900 (DCSO records Vol. 9 Page(s) 3600-1)

Set basalt stone 18x10x6", 12" in the ground for 1/4 sec. cor. marked 1/4 on W faces, from which

A maple, 7" dia., bears N.53°E., 7 lks., mkd: 1/4 S12 BT.
An arbutus, 24" dia. bears N.38°W., 12 lks. mkd: 1/4 S11 BT.

V.W. Hosford - Oct. 1957 - C.S. File 42/308-11

Before logging I found the original marked stone corner in place, and the arbutus bearing tree for Section 11 in good condition. The Maple bearing tree for section 12 was gone. After logging in Section 11 and the N 1/2 of section 12, I was not able to find the corner stone. The Arbutus bearing tree has been broken down and badly burned and its original position lost.

I found old transit hubs on my random E. & w. center line of Sec. 12, which I had established in 1949. The terminus of this survey line was the corner 11 & 12. From station 53 + 39.1 re-produced this line S.89°02'W., 145.6 ft.; thence, N.12°39'E. 15.1 ft. to the point of the original corner, there I drove a 1 1/2" iron pipe 36" long 24" in the ground, from which:

A Fir 40" in dia., bears S.64 1/2°E. 23.7 ft. marked 1/4 S 12
253 BT

An Incense Cedar 18" dia, bears S.71 1/2°W., 81.1 ft. marked
1/4 S 11 253 BT

Glen McChesney, Weyerhaeuser Co. - 7/28/1970 - C.S. 53/112-18

Found - No trace of OBT
1 1/2" iron pipe & BTs (1957)
42" Fir, S.65°E., 23.7 ft., scribing visible, dist. measured to face.
22" I.Cedar, S.71 1/2°W., 81.1 ft., scribing visible, dist. measured to face.

New - Added "W" nail & plate to 2 fd. BTs.

Steven Ness, L.S. #811 - For: Weyerhaeuser Co. - Oct. 1995 - M 123-3 A&B

Found - 1 1/2" Iron pipe.
46 D.Fir stump S.65°50'E., 25.4 ft. to center. 23.32 to "W" nail. Face not healed. Scribing "253 BT" visible. (S.65°E. 23.2) 8/6
26" x 4' - 30 I.Cedar S.71°15'W., 81.2 face healed. (S.72°W., 81.10) continued next page
TALL

CS 67/58-21 3/4 1

TOWNSHIP 25 RANGE 02 POINT IDENTIFIER # 600540

PRIMARY CORNER DESCRIPTION 1/4 Cor. Secs. 11 & 12

Alias _____	Description _____
Alias _____	Description _____
Alias _____	Description _____
Alias _____	Description _____

23^A
 New BTs - 11" D. Fir S. 7°16'W., ~~25.1~~^{25.3} to center. 24.4 to "W" nail. Scribed "1/4 S11 BT. 38¹"
 22^B - 10" D. Fir N. 66°05'W., ~~38.3~~ to center. 37.8 to "W" nail. Scribed "1/4 S11 BT."

BLM resurvey by A. Bert Skeesick, Cadastral Surveyor, Group #1979, surveyed 2001/2002- (DCSO rec. Vol. 54 Pages 20938-9)

 The 1/4 sec. cor. of secs. 11 & 12 bears S. 89°14'05"E., 2584.34 ft., perpetuated by Hosford, in 1957, further perpetuated by Ness, in 1995, monumented with an iron pipe, 2" dia., firmly set, projecting 10" above ground, with no cap, from which the remains of the bearing trees mkd. by Hosford
 A fir stump, 48" dia., bears S. 65 1/4°E., 24.8 ft., with scribe marks 25 3 BT visible on partially healed blaze.
 ✓ A cedar stump, 36" dia., bears S. 71 1/2°W., 81.0 ft., with healed blaze.
 and bearing trees mkd. by Ness ✓
 ✓ A fir, 14" dia., bears S. 7 1/2°W., 25.0 ft., with healed double blaze.
 ✓ A fir, 12" dia., bears N. 66 1/2°W., 38.1 ft., with healed double blaze.
 At the corner point
 Set a stainless steel post, 28" long, 2 1/2" dia., 18" in the ground, over existing iron pipe, in a mound of earth and stone, 2 ft. base to top, with brass cap mkd.
 T25S R2W
 1/4
 S 11 | S 12
 2001
 Deposit a magnet in a white plastic case at the base of the stainless steel post.

NEW - 13" I. CEDAR, S 40 W, 24³
 STEEL LATH 1 FT EAST
 ALL RIGHT SIDE IS STEEL
 CS 67/58-21
 4/4

TOWNSHIP 25S RANGE 2W SEC. 11

PLSS # 600540

Date: 6/5/2023 By: E

This survey consists of:

Map: _____

Narrative: _____

Corner Rpt: CS 67/56-13

DOUGLAS COUNTY OREGON

DATE 5-4-23

DOUGLAS COUNTY
SURVEYOR

Corner Designation

1/4 COR S11/S12

Monument(s) Found: (Condition and Source)

BLM BRASS CAP up 10"

Rough Stone MOUND

AROUND BASE

Previous Renewals

Hosford 1957 CS 42/308

McChesney 1970 CS 53/112-18

Ness 1995 M 123-3 A & B

BLM Resurvey 2001/2002

Vol 54 pgs 20938-9

___ Condition report

___ Not Found

___ Renewed

___ Unrecorded

___ Surveyed In

MONUMENT DETAIL

T25S R2W

1/4

S11/S12

2001

Accessories Found

Burned - Rotted 38" X 3 FT FIR STUMP
56 S 1/4° E 29.8 FT

18" X 5 FT BURNED CEDAR STUMP S 71 1/2° W
81.6 FT (REC 81.0 FT)

BURNED DEAD 16" D. FIR S 7 1/2° W 25.2 FT
(REC 25.0 FT) Fully healed Double BLAZE
ADD 3 1/2" MAG NAIL RIGHT Side Center

BURNED - DEAD 23" D. FIR N 66 1/2° W 38.1 FT
Fully Healed Double BLAZE ADD 3 1/2" MAG
NAIL RIGHT Side Center

Steel Post 1 FT EAST OF B.C.

New Accessories

BURIED - DEAD 16" Red Cedar 540°W 24.3 FT
Not BLAZED or Scribed ADD 3 1/2" MAG
NAIL RIGHT SIDE CENTER

8' FT X 30' FT BASALT WALL N11E 10 FT ±

Sketch of Monument, Accessories, and General Area

small stream flows southerly
is west 20 FT monument
just above bottom of
DRAW

OARS Coordinate System
Cottage Grove - Canyonville
Zone

N 210270.846
E 280650.476

Location & Comments

monument is
470' E EAST OF
GRAVEL ROAD

AREA BURNT
9-2020


Comp. Decline. 14 1/2° E

Agency DCSO

Party Chief S. Frause

Note keeper

Witnesses J. Loring

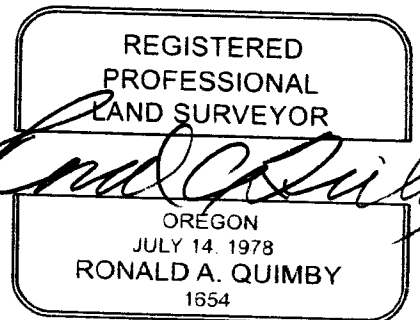

EXPIRES: 12/31/2024

5/4/23

TOWNSHIP 25 RANGE 02 POINT IDENTIFIER # 600540

PRIMARY CORNER DESCRIPTION 1/4 Cor. Secs. 11 & 12

Alias _____ Description OORS CANYONVILLE
 Alias _____ Description COTTAGE GROVE COORDS
 Alias _____ Description _____
 Alias _____ Description 210270.846 N
280650.476 E

New BTs- 11" D.Fir S.7°16'W., 25.1 to center. 24.4 to "W" nail. Scribed "1/4 S11 BT."
 10" D.Fir N.66°05'W., 38.3 to center. 37.8 to "W" nail. Scribed "1/4 S11 BT."

BLM resurvey by A. Bert Skeesick, Cadastral Surveyor, Group #1979, surveyed 2001/2002- (DCSO rec. Vol. 54 Pages 20938-9)

The 1/4 sec. cor. of secs. 11 & 12 bears S.89°14'05"E., 2584.34 ft., perpetuated by Hosford, in 1957, further perpetuated by Ness, in 1995, monumented with an iron pipe, 2" dia., firmly set, projecting 10" above ground, with no cap, from which the remains of the bearing trees mkd. by Hosford

BURNED ROTTED
18" x 5FT BURNED

A fir stump, 48" dia., bears S.65 1/4°E. 24.8 ft., with scribe marks 25 3 BT visible on partially healed blaze.

A cedar stump, 36" dia., bears S.71 1/2°W. 81.8 ft., with healed blaze. **BLAZE BURNED OUT**

{ADD 3 1/2" MAG NAIL R.S.C. TO FOUND BTs EXCEPT NE STUMP}

and bearing trees mkd. by Ness
 fir, 14" dia., bears S.7 1/2°W., 25.8 ft., with healed double blaze.

BURNED DEAD 16" AD
BURNED DEAD 23" AD

fir, 12" dia., bears N.66 1/2°W. 38.1 ft., with healed double blaze.

At the corner point set a stainless steel post, 28" long, 2 1/2" dia., 18" in the ground, over existing iron pipe, in a mound of earth and stone, 2 ft. base to top, with brass cap mkd.

T25S R2W
 S 11 | S 12
 2001

MONUMENT IN STEEP ROCK RUBBLE SLOPE PROT 10" ABOVE GROUND ROUGH STONE MOUND OF STONE AROUND BASE

Deposit a magnet in a white plastic case at the base of the stainless steel post.

FOUND A STEEL LATH 1 FT. EAST FROM B.C. MON.

NEW REF

BURNED DEAD 16" R. CEDAR 3 1/2" MAG NAIL R.S.C. S40°W, 24.3

8' x 30' BASALT WALL, NNE ≈ 10 FT.

SMALL STREAM RUNNING SOUTHERLY IS WEST, 20 FT. MONUMENT JUST ABOVE BOTTOM OF DRAW ≈ 470' EAST FROM GRAVEL RD.

DECLINATION 14 1/2° E

CS 67/56-13
 3/3