

GOVERNMENT CORNER RESTORATION FORM

FILED

TOWNSHIP 26S RANGE ~~12~~ 2W SEC. 13

PLSS # 700444

Date: 7/10/2024 By: X
This survey consists of:

DOUGLAS COUNTY OREGON

DATE 7-2-24

Map: _____

Narrative: _____

Corner Rpt: CS 67/58-22

DOUGLAS COUNTY
SURVEYOR

Corner Designation

E 1/4 COR S13 ONLY

Monument(s) Found: (Condition and Source)

3" BRASS CAP BURIED
4"

___ Condition report

___ Not Found

Renewed

___ Unrecorded

___ Surveyed In

Previous Renewals

Mench 1910 Vol 10 pg 4086-7
GLO Survey 1913 Vol 10 pg 4264
GARRETT 1972 M 47-7
FARR 1984 CS 62/15-17
DCSD 1992 CS 64/23-14
Hoffine 2007 M 153-43
see other side

MONUMENT DETAIL

T2LS RIW
1/4
S13 |
1972
RPLS 544

Accessories Found

BURIED 14" FIR N 80 1/2° E 116.5 FT HEALED
BLAZE

32" WILLOW N 1° W 31.9 FT NO MARKS
VISABLE ADD 3 1/2" MAG NAIL RIGHT
SIDE CENTER

A 9" MAPLE S 37 1/2° W 25.2 FT VISABLE
SCRIBE X T O N MARK ADD 3 1/2"
MAG NAIL RIGHT SIDE CENTER

A Metal +- Post is alongside the corner with USFF Signs

RENEWAL

Monument Set (Procedure and Description)

MONUMENT DETAIL

Previous Renewals
 STANLEY ODOT Nov 2007
 ST. HWY 138 - OHC
 Hoffinc 2010 M 161-10
 BLM Resurvey 7/2018 to
 3/2020 Vol 59 pg 740A3-4

New Accessories

Sketch of Monument, Accessories, and General Area


Location & Comments

OGRS COORDINATE SYSTEM
 Cottage Grove - Canyonville
 Zone

AREA BURNED
 9/2020

N 172856.655
 E 286511.854

Comp. Decline. 14 1/2° E
 Agency DCSO
 Party Chief J. Corsung
 Note keeper _____
 Witnesses _____

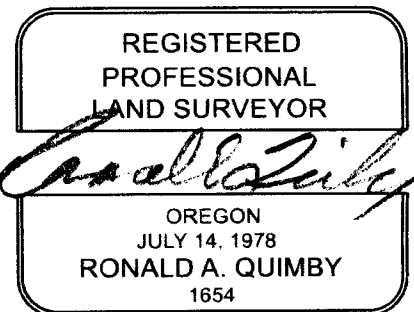

EXPIRES: 12/31/2024

CS 67/58-22 2/3

TOWNSHIP 26 RANGE 01 POINT IDENTIFIER # 100444

PRIMARY CORNER DESCRIPTION E. 1/4 Cor. for Sec. 13 only, T26-2

Alias _____	Description _____
Alias _____	Description _____
Alias _____	Description _____
Alias _____	Description _____

Ken Hoffine - For: Lone Rock Timber Management Co. - July 2010 - M161-10

Found - 1972 Garrett brass cap 0.4 feet below ground in bamboo thicket
 Steel fence post bears N.0½°E., 5.0 feet as per record
 17" Willow bears N.5¼°E., 33.2 ft as per record
 13" D.Fir bears N.81°E., 116.5 ft as per record
 Corner lies approx. 1.0 feet east of a 3'x6'x6' boulder and approx. 18 feet east of small pond.

BLM dependent resurvey by Jeffrey O. Covington, Cadastral Surveyor, under Group No. 2923, surveyed July 2018/March 2020- (DCSO records Vol. 59 Pages 24043-4)

The ¼ sec. cor. of sec. 13 only, reestablished by proportionate measurement by Garrett, in 1972; perpetuated by Farr, in 1984; subsequently perpetuated by Smith, in 1992. There is no remaining evidence of the original cor., therefore this point is accepted as a careful and faithful reestablishment of the cor.; monumented with an iron post, 2½" dia., firmly set, with top 4" below the surface of the ground, with a brass cap (properly) mkd. from which a bearing tree mkd. by Farr

BURNED - A fir, 14" dia., bears N.80½°E., 116.5 ft., with a healed blaze.

and a bearing tree mkd. by Smith
ALIVE - A willow, 32" dia., bears N.1°W., 31.9 ft., no marks visible. *SPIKED / TAGGED*

and a new bearing tree
ALIVE - A maple, 9" dia., bears S.37½°W., 25.2 ft., mkd. X BT on bark. *SPIKED / TAGGED*

Corner is located in a bamboo thicket, E., 1.0 ft., of a boulder, 3x6x6 ft. A metal t-post is alongside the cor., with Forest Service signs Nos. 54-2 and 54-4 attached. Each new BT has a 2½"x ¼" magnetic nail (Mag Nail) driven at the base right side-center & each monument established or remonumented has a magnet deposited in a white plastic case at the base of the stainless steel post. Alum. Angle iron driven alongside each monument unless a similar marker was already in place.

CS 67/58-22