

GOVERNMENT CORNER RESTORATION FORM

FILED

TOWNSHIP 255 RANGE 2W SEC. 12

PLSS # 640540

Date: 7/22/2024 By: [Signature]

This survey consists of:

DOUGLAS COUNTY OREGON

DATE 7-11-24

Map: \_\_\_\_\_

Narrative: \_\_\_\_\_

Corner Rpt: CS 67/58-27

Corner Designation

DOUGLAS COUNTY SURVEYOR

C 1/4 S 12

Monument(s) Found: (Condition and Source)

Condition report

2 3/4" BRASS CAP ON

Not Found

2" Iron pipe up 8"

Renewed

Unrecorded

Previous Renewals

Surveyed In

Ness 1995 M 123-3 A-B

MONUMENT DETAIL

T 255 R 2W

C 1/4 S 12

1995

R PLS 811

Accessories Found

30" X 4 FT D. Fir Stump N 25° 54' E 31.2 FT

33" X 4 FT D. Fir Stump N 55° 14' E 19.6 FT

14" D. Fir S 21° 44' E 57.3 FT

All dist To Center All have "W" NAIL IN FACE

Metal "U" Post 2 FT west

C.S. File 67/58-27

Monument Set (Procedure and Description)

MONUMENT DETAIL

---



---



New Accessories

6" BURNED YEW NB<sup>90</sup>W 5.2 FT 3 1/2"  
 MAG NAIL RIGHT Side Center

---



---




Sketch of Monument, Accessories, and General Area

Location & Comments

OCRS Coordinate System  
 Cottage Grove - Canyonville  
 Zone

N 210284.182  
 E 283343.034

Comp. Decline. 1474 E  
 Agency DCSO  
 Party Chief S F Haase  
 Note keeper  
 Witnesses J. Lorusso

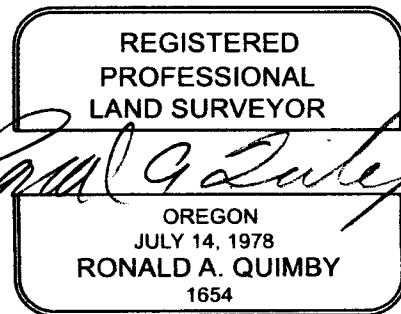

EXPIRES: 12/31/2024

CS 67/58-27  
 2/3

TOWNSHIP 25 RANGE 02 POINT IDENTIFIER # 640540

PRIMARY CORNER DESCRIPTION Center 1/4 Cor. Sec. 12

Alias _____	Description _____
Alias _____	Description _____
Alias _____	Description _____
Alias _____	Description _____

RENEWED 7/11/24

DECLINATION  $14\frac{1}{4}^{\circ} E$

Steven Ness, L.S. #811 - For: Weyerhaeuser Co. - Oct. 1995 - M 123-3 A&B

PROJ 8" PROPERLY MARKED

Set -  $2\frac{3}{4}$ " brass cap cemented to the top of a 2"x42" iron pipe.

- 30" x 4 FT ~~32"~~ D.Fir, N.25°54'E., 31.2 to center, 30.60 to "W" nail. Bark scribed, "C $\frac{1}{4}$  S12 BT"
- 33" x 4 FT ~~35"~~ D.Fir, N.55°14'E., 19.6 to center, 18.75 to "W" nail. Bark scribed, "C $\frac{1}{4}$  S12 BT"
- 14" 8" D.Fir, S.21°44'E., 57.3 to center, 56.87 to "W" nail. Scribed, "C $\frac{1}{4}$  S12 BT"
- GONE 8" ~~D.Fir, S.27°43'W., 33.8 to center, 33.45 to "W"~~ nail. Scribed, "C $\frac{1}{4}$  S12 BT"

NAILS IN PLACE

GCRS - N 210284.182, E 283343.934

NEW 6" BURIED YEW, N 8° W, 5 $\frac{2}{3}$  FT

RSC SPIKED 3/8" M-NAIL

METAL U-POST 2 FT WEST

CS 67/58-27

3/3