

GOVERNMENT CORNER RESTORATION FORM

FILED

TOWNSHIP 256 RANGE 2W SEC. 7

PLSS # 100546 Date: 7/31/2024 By: SC
This survey consists of:

DOUGLAS COUNTY OREGON

DATE 7-17-24

Map: _____

Narrative: _____
Corner Rpt: CS67/58-37

Corner Designation

DOUGLAS COUNTY
SURVEYOR

W 1/4 COR SEC 7 ONLY

Monument(s) Found: (Condition and Source)

___ Condition report

2 1/2" GLD BRASS CAP

___ Not Found

proj 6" ADD Rough mound
OF stone AROUND Pipe

Renewed

Previous Renewals

___ Unrecorded

___ Surveyed In

GLD Resurvey 1940 Vol 27

pg 11517

DCSO 1966 CS 54/27-165

BLM Resurvey 2010-2011

Vol 57 pg 22790

MONUMENT DETAIL

1/4 57
1943

Accessories Found

Burnt SAWN Rotted 32" x 3 1/2 FT Fir Stump
S 89 1/2° E 33.0 FT. Healed BLAZE

Burnt SAWN Rotted 28" x 4 FT Fir Stump
S 67° E 34.9 FT (Rec 37.6 FT) BLAZE GONE

Burned - Dead 39" Hemlock N 19 1/2° E 19.8 FT
(Rec 19.4 FT Healed Double BLAZE ADD 3 1/2"
MAG Nail RIGHT SIDE CENTER

Burned Dead 5" Fir S 36° E 18.9 FT (Rec 19° FT)
Burned out Double BLAZE ADD 3 1/2" MAG
Nail RIGHT SIDE CENTER

Alum post 1 FT South

C.S. File 67/58-37

Monument Set (Procedure and Description)

MONUMENT DETAIL

New Accessories

BURNED DEAD 8" Hemlock N53°E 6.2 FT
3 1/2" MAG Nail RIGHT SIDE CENTER

Sketch of Monument, Accessories, and General Area

Location & Comments

MON. ON moderate EAST Slope
Burned old Growth EAST
Clearcut to west


GRUVE ROAD
APPROX 200 FT
WEST

AREA BURNED
9/2020

OCES Coordinate System
Cottage Grove - Canyonville
zone

Comp. Decline. 14 1/4° E
Agency DCSO
Party Chief S. F. HAUSE
Note keeper
Witnesses J. LORSUNG

N 210078.135
E 255345.983

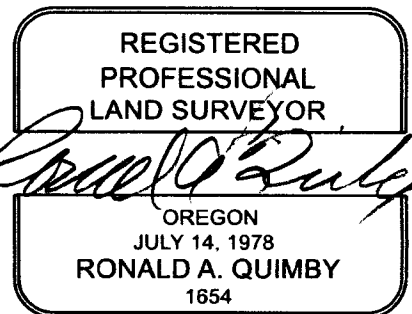

CS 67/58-37
213

PRIMARY CORNER DESCRIPTION W. 1/4 Cor. Sec. 7 only

Alias _____	Description _____
Alias _____	Description _____
Alias _____	Description _____
Alias _____	Description _____

GLO Dependent Resurvey by Norman D. Price, Under Special Instructions dated April 5, 1940 (DCSO records, Volume 27 Page 11517)

Mid-point on the W. bdy. of Sec. 7. Set an iron post 3 ft. long, 1" dia., 28" in the ground, for 1/4 sec. cor. of sec. 7 only, with brass cap mkd. 1/4 S7

- 1943 from which
- A Fir 36" dia., bears S.57 1/2°E., 57 lks., mkd. 1/4 S7 BT.
- A Fir 30" dia., bears S.81 1/2°E., 50 lks., mkd. 1/4 S7 BT.

Douglas Co. Surveyors Office - Vernon Tracy; Mike Stone; Jack Heritage - February 1966 - C.S. File 54/27-165

Found - 1943 GLO brass cap under 36" log.
 36" now 38" Fir, 4 ft. high stump, S.57 1/2°E., 37.6 ft., face pitched over & nearly healed, no scribe visible.
 30" now 32" Fir stump 3 ft. high, S.81 1/2°E., 33.0 ft. healed blaze.

New BT - 30" Hemlock N.18°E., 19.4 ft. mkd. 1/4 S7 CS BT. (bearing approx. from top of log over brass cap.)

No trees to SE due to logging.
Corner lies in NW cor. of cut unit.

RENEWED 7/17/24

DECLINATION 14 1/4°E

BLM Dependent Resurvey by A Bert Skeesick, Cadastral Surveyor Under Group No. 2317, Surveyed June 2010/June 2011 - DCSO records Vol. 57 Page(s) 22790

The 1/4 sec. cor. of sec. 7 only, on the W. bdy. of the Tp. perpetuated by the Douglas County Surveyors Office in 1966, monumented with an iron post, 1 1/4" dia., firmly set, projecting 7" above the ground, with brass cap (properly) mkd from which the remains of bearing trees mkd. by Price

MINI GIS
43,40919
122,98972

BURNED SAWN ROTTED
32" x 3 1/2 FT. STUMP

BURNED SAWN ROTTED
28" x 4 FT. STUMP

BURNED DEAD
39" A hemlock, 38" dia., bears N.19 1/2°E., 19 ft., with a healed double blaze

BURNED DEAD
5" A fir, 6" dia., bears S.36°E., 19.8 ft., mkd. 1/4 S7 BT.

2 1/2" GLO B.C. / P. MARKED AS ABOVE PROT. 16"
ADD ROUGH MOUND OF STONE AROUND PIPE

A sawed, decayed fir stump, 40" dia., bears S.89 1/2°E., 33.0 ft., with a healed blaze. (Record, S.81 1/2°E.)
A sawed, decayed fir stump, 35" dia., bears S.67°E., 37.6 ft., with scribe marks S7 B visible on a partially healed blaze. (Record, S.57 1/2°E.)

and a BT mkd. by the Douglas County Surveyor's Office and a new bearing tree

198 ADD 3 1/2" MAG NAIL R.S.C. TO BOTH TREES

ALUMINUM LATH FND. 1 FT SOUTH
NEW REF.

CS 67/58-37
313

A BURNED DEAD 8" DIA HEMLOCK WITH A 3 1/2" MAG NAIL R.S.C. N 53°E, 62 FT.
OCS CANYONVILLE COTTAGE GROVE COORD.S NOT GOOD

MON. ON MODERATE EAST SLOPE BURNED OLD GROWTH EAST CLEAR CUT WEST GRAVEL ROAD APPROX 200 FT. WEST