

GOVERNMENT CORNER RESTORATION FORM

TOWNSHIP 26S RANGE 2W SEC. 34

PLSS # 500120

FILED Date: 7/31/2024 By: X

This survey consists of:

Map: \_\_\_\_\_

Narrative: \_\_\_\_\_

Corner Rpt: CS 67/58-38

DOUGLAS COUNTY SURVEYOR

DOUGLAS COUNTY OREGON

DATE 7-25-24

Corner Designation

S 1/4 S34 | S35

Monument(s) Found: (Condition and Source)

2 1/2" Alum. Cap on 3/4" Iron  
Rod (Bent East 1 1/2 FT Straighten  
To plumb position up 4"

Previous Renewals

Set by SHAWER 2001  
per M 132-70

- Condition report
- Not Found
- Renewed
- Unrecorded
- Surveyed In

MONUMENT DETAIL

Roseburg Resources  
CO.  
S 1/4  
S34 | S35

RLS 430 2001

Accessories Found

Singed - SNWN 15" X 6 FT D. FIR STUMP  
S 68° W 3.1 FT Fully Healed Single  
TS 142E

Monument Set (Procedure and Description)

MONUMENT DETAIL

New Accessories

Singed - SAWN 14" x 1 1/2 FT D. Fir  
Stump N 90W 18.5 FT 3 1/2" MAG  
Nail Top Center

Sketch of Monument, Accessories, and General Area


Location & Comments

OCRS Coordinate System  
Cottage Grove - Canyonville  
zone

N 156155.613  
E 276329.470

AREA BURN  
9/2020

Comp. Decline. 14 1/4° E  
Agency DCSD  
Party Chief S. F. Aulse  
Note keeper  
Witnesses J. LORSUNG

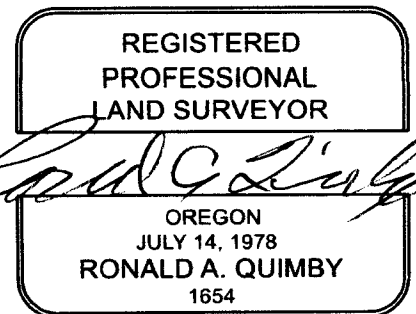

EXPIRES: 12/31/2024

CS 67/58-38  
213

7/25/24

FILED

Date: 2/1/2001 By: JP

This survey consists of:

Map: M 132-70

Narrative:

Corner Rpt: CS 65/36-2L

OREGON CORNER RESTORATION FORM

Section 3A Township 26S Range 2W

County Douglas Date Jan. 24, 2001

DOUGLAS COUNTY SURVEYOR

Corner Designation

S 1/16  
S34 | S35

- Condition Report Only
- Not Found
- Renewed
- Unrecorded
- Surveyed In
- Referenced Out

Previous Renewals/Surveys, etc.

None.

Monument(s) & Accessories Found: (Condition and Source)


None.

DECLINATION 14 1/4 ° E

SINGED SAWN STUMP 1 1/4" X 1 1/2" D. FIR 3 1/2" MAG NAIL BEARS N 04 ° W, 18 5  
STUMP TOP CENTER

Monument Detail

Sketch

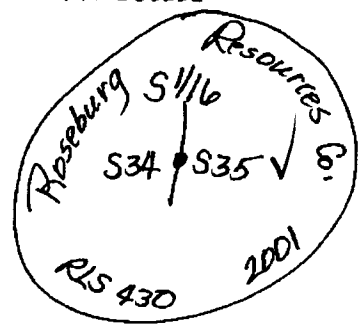

CORSCANYONVILLE COTTAGE GROVE COORD. S

156 155.613 N  
276 329.470 E

FOUND TOP BENT  
EAST 1 1/2 FT,  
STRAIGHTEN TO PLUMB POS.  
NOW PROT. 4"

Monument Set (Procedures and Description)

I set a 3/4" x 40" Iron Rod with a 2 1/2" Alum. Cap  
From which a:

New Accessories

GONE IN LANDING 1/4" D. FIR BT, I scribed "S35 S 1/16 BT" bears N 70 ° E,  
125 feet.

SINGED SAWN 15" x 6 FT 1/4" D. FIR BT, I scribed "S34 S 1/16 BT" bears S 68 ° W, 31 feet. ✓ FHSB

GONE 6 Foot Alum. Post bears South, 12 feet

Location & Comments

Surveyor's Seal

Compass Declination 20 ° E  
 Firm/Agency Shaner Engineering  
 Address RD 1 Box 1430 Roseburg, Oregon 97470  
 Party Chief B. Shaner  
 Notes " "  
 Witness Ren Schneider

REGISTERED PROFESSIONAL LAND SURVEYOR

Bruce A. Shaner  
OREGON OCT. 4, 1957  
BRUCE A. SHANER 430

CS 67/58-38  
3/3

Gregg Pawskine

Renewed June 30, 2002

C.S. File No. 65/36-2L