

GOVERNMENT CORNER RESTORATION FORM

FILED

TOWNSHIP 265 RANGE 3W SEC. 25 PLSS # 700240

Date: 7/31/2024 By: JC

This survey consists of:

Map: \_\_\_\_\_

Narrative: \_\_\_\_\_

Corner Rpt: CS 67/58-39

DOUGLAS COUNTY OREGON

DATE 7-25-24

DOUGLAS COUNTY SURVEYOR

Corner Designation

R3W, R2W  
1/4 S25/S30

Monument(s) Found: (Condition and Source)

STACKED MOUND OF  
STONE

Condition report

Not Found

Renewed

Unrecorded

Surveyed In

Previous Renewals

GLO 1855 Vol 10  
Pg 4177

MONUMENT DETAIL

Accessories Found

NO ORIGINAL ACCESSORIES WERE SET  
USING GIS MAP LOCATION AND HAND  
HELD GPS WE FIND 1855 STACKED  
MOUND OF STONE 2 FEET BASE 1 FT  
TALL. FIRST IDENTIFIED AS UNUSUAL  
MOSS COVERED MOUND REMOVING MOSS  
REVEALS MANUALLY STACKED STONES  
WITH POST VOID IN CENTER

Topog Call Fit Well

RENEWAL

Monument Set (Procedure and Description)

2 1/2" DC SO ALUM CAP  
ON 5/8" X 30" IRON ROD  
SET 4" ABOVE TOP  
CENTER OF FOUND STONE  
WOUND

MONUMENT DETAIL

Douglas County

1/4  
525 | 530

New Accessories

Surveyors Office

20" Hemlock N 12 1/2° E 24.3 FT Scribed  
T26 1/4 530 BT ON Double BLAZE  
9" Singed D. FIR N 81° E 13.5 FT Scribed  
1/4 530 BT ON Double BLAZE  
9" Singed FIR S 2 1/2° W 25.7 FT Scribed  
1/4 525 BT ON Double BLAZE  
(LIVE) 5" D. FIR N 20° W 15.5 FT Scribed X BT ON  
HIGH LOW BLAZE

All Trees spiked with 3 1/2" mag Nails  
RIGHT side center

Sketch of Monument, Accessories, and General Area

Location & Comments


MON IS ON Easterly FACE  
OF BROAD Ridge Running  
SSE IN Old FIRE Regrowth  
FIR AND Hemlock Forest

AREA BURNED  
9-2020

OCRS COORDINATE SYSTEMS  
Cottage Grove Canyonville  
Zone

Comp. Decline 14 1/4° E  
Agency DC SO  
Party Chief S. F. HAUSE  
Note keeper  
Witnesses J. LORSUNG

N 162499.315  
E 255239.969

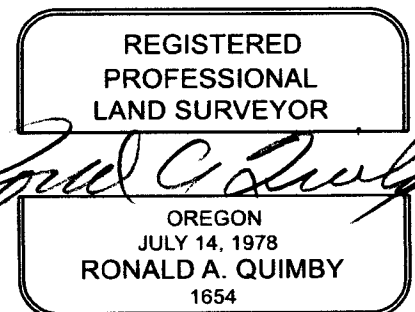

SEE Photo

CS 67/58-39  
215

EXPIRES: 12/31/2024

TOWNSHIP 26 RANGE 03 POINT IDENTIFIER # 700240

PRIMARY CORNER DESCRIPTION 1/4 Cor Secs 25 & 30, T26-2 **RENEWED**

Alias _____	Description <u>DECLINATION 14 1/4° E</u>	<u>7125124</u>
Alias _____	Description _____	
Alias _____	Description _____	
Alias _____	Description <u>OLRS CANYONVILLE COTTAGE GROVE COORDS</u>	

162499.315 N  
255239.969 E

Douglas Co. Surveyors Office - V.R. Tracy - Feb. 1966 - C.S.

File 54/7-45A USING GIS MAP LOCATION AND HANDHELD GPS WE FIND

1855 STACKED MOUND OF STONE MEASURING 2 FT. IN DIAM. X 1 FT. TALL  
~~Not found~~ FIRST IDENTIFIED AS UNUSUAL MOSS COVERED MOUND,  
REMOVING MOSS REVEALS MANUALLY STACKED STONES WITH POST VOID IN CENTER.

**NEW REFS** - 20" LIVE HEMLOCK SCRIBED "T26 1/4 S30" "BT" ON A N 12 1/2° E, 34 3  
DOUBLE BLAZE

9" SINGED D. FIR SCRIBED "1/4 S30" "BT" ON DOUBLE N 81° W E 13 5  
BLAZE

9" SINGED D. FIR SCRIBED "1/4 S25" "BT" ON A DOUBLE S 02 1/2° W, 25 7  
BLAZE

5" LIVE P. FIR SCRIBED "X" "BT" ON HIGH-LOW BLAZE N 20° W, 15 5

WE ADD 2 1/2" ALUMINUM CAP ON A 5/8" X 30" IRON ROD SET WITH  
TOP PROTRUDING 4 INCHES ABOVE TOP CENTER OF FOUND STONE MOUND.

MONUMENT IS ON EASTERY FACE OF BROAD SHALLOW SSE RUNNING  
RIDGE IN OLD FIRE REGROWTH FIR AND HEMLOCK FOREST.

CAP IS STAMPED "DOUGLAS COUNTY"

1/4  
S25 | S30  
SURVEYOR'S OFFICE

SEE Photo

CS 67/58-39

3/5

3 1/2" MAGNAIL R.S.C.

43.27854  
122.99084

-1-  
County Surveyor's Record, Douglas County, Oregon

4177

East Bdy. of T. 26 S., R. 3 W.  
As surveyed by Addison R. Flint, Deputy Surveyor  
Under Contract No. 58  
Dated March 1, 1855

CHAINS		
	North on true east boundary of sec. 36 Va. 18°E.	
40.00	Set $\frac{1}{4}$ sec. post, from which A red fir, 12 ins. diam., bears N.50°E., 24 lks. dist. A red fir, 12 ins. diam., bears S.21°W., 52 lks. dist.	150
66.00	Brook, 5 lks. wide, runs SW	50
80.00	Set post cor. to secs. 25, 36, 30 & 31, from which A red fir, 26 ins. diam., bears S.45°E., 33 lks. dist. A red fir, 30 ins. diam., bears N.22°E., 30 lks. dist. A laurel, 12 ins. diam., bears S.68°W., 40 lks. dist. No trees convenient NW Land, 3rd rate, very broken & hilly Timber, principally fir-some oak, pine, cedar, and laurel	60
	North on true East boundary of sec. 25 Va. 18°15'E.	
20.00	Summit of hill	75
32.50	Brook, 4 lks. wide, runs SE	50
40.00	Set $\frac{1}{4}$ sec. post around which a mound of stones was raised as per instructions, no trees convenient	30
80.00	Set post cor. to secs. 24, 25, 19 & 30, from which A laurel, 5 ins. diam., bears N.2°E., 27 lks. dist. A laurel, 6 ins. diam., bears N.55°W., 32 lks. dist. A R fir, 4 ins. diam., bears S.88°E., 17 lks. dist. A R fir, 4 ins. diam., bears S.48°W., 35 lks. dist. Land, 3rd rate, rough & hilly Timber principally fir, some oak, cedar, sugar-pine, laurel	150
	North on true East boundary of sec. 24 Va. 18°E.	
26.00	Brook 5 lks. wide runs SE	50
40.00	Set $\frac{1}{4}$ sec. post, from which A chinquapin, 7 ins. diam., bears East, 14 lks. dist. A spruce, 15 ins. diam., bears S.25°W., 15 lks. dist.	80
66.00	Summit of hill	150

THESE CALLS  
AGREE WELL  
WITH TERRAIN

CS 67/58-39  
4/15

**Retracement-Reestablishment  
Portion of W. Bdy. of T. 26 S., R. 2 W.**

CHAINS

This cor. stands at head of steep ravine, course W  
Creek  
Rock<sup>1</sup>s about 12 chs. to the west

The true course and distance of this line from the  $\frac{1}{4}$  sec.  
cor. is North, 40.05 chs.

Sky overcast at noon, latitude observation impossible

Note:

Survey postponed pending action and the issuance of  
Supplemental Special Instructions based on the report of  
my preliminary examination as to the condition of old sur-  
veys in this township.

May 31, 1913.

Survey resumed October 25, 1913.  
Thence I run

South, retracing the line bet. secs. 25 and 30.

Descend gradual slope through heavy timber and dense under-  
growth.

4.35 Stream, 2 lks. wide, course E.; ascend

13.18 Trail, bears E and W.

40.01 Fall 51 lks. W. of the  $\frac{1}{4}$  sec. cor., which is a fir post,  
firmly set, marked and witnessed as described by the  
surveyor general.

This is probably not the original cor. post, but it is set  
in the original mound of stone and was evidently placed  
there to perpetuate the old cor., which had become de-  
cayed.

The true course and distance of this line is S.0°44'E.,  
40.01 chs.

I continue my line South from the  $\frac{1}{4}$  sec. cor., counting  
distance from the sec. cor.

THIS CALL IS  
IN CORRECT.  
CLOSER TO  
42.43 CHNS

43.75 Bottom of ravine, course S.80°E.

63.84 Trail, bears E and W.

77.65 Kaolin prospect shaft, bears W., 20 lks. dist.

79.88 Fall 50 lks. W. of the point for cor. of secs. 25, 30, 31  
and 36, located by reference to the bearing trees as  
described by the surveyor general; all other traces of

CS 67/58-39  
5/5