

GOVERNMENT CORNER RESTORATION FORM

FILED

TOWNSHIP 26S RANGE 2W SEC. 34 PLSS # 440120

Date: 8/19/2024 By: [Signature]
This survey consists of:

DOUGLAS COUNTY OREGON

DATE 7-29-24

Map: _____

Narrative: _____

Corner Rpt: CS 67/58-42

Corner Designation

CS 1/16 534

DOUGLAS COUNTY
SURVEYOR

Monument(s) Found: (Condition and Source)

___ Condition report

2 1/2" Alum CAP ON 3/4" IRON

___ Not Found

ROD - Bent Return To Plum
Under Post WAD REMOVE WAD CAP

Renewed

Previous Renewals Now 4 P 3"

___ Unrecorded

___ Surveyed In

Set by SHANKER 2001

M 132-70 & CS 65/36 26

MONUMENT DETAIL

Roseburg Resources
CO.

CS 1/16

RLS 430 2001

Accessories Found

Sawn -

BURNED - Rotted 12" x 6 FT D. FIRE STUMP
N 39° W 8.1 FT FACE BURNT AWAY

26" D. FIRE S 88° W 24.0 FT (REC S 85° W 23.5 FT)
Fully healed BLAZE ADD 3 1/2" NAG NAIL
RIGHT Side Center

6 Foot Steel Fence post 1 FT West
AND 1 Foot South (Pd Bent over - Straighten Up)

C.S. File 67/58-42

RENEWAL

Monument Set (Procedure and Description)

MONUMENT DETAIL

New Accessories

5" D. FIR 556°W 24.5 FT scribed "X" "BT"
ON HIGH LOW BLAZE 3 1/2" MHg V411
RIGHT side center

Sketch of Monument, Accessories, and General Area

Location & Comments


MON ON EAST EDGE OF SMALL
bench ON moderately westerly
slope old growth in SW QUAD
Reprod To S.E Clear Cut to
North

AREA BURNED
9-20-20

DCRS COORDINATE SYSTEM
Cottage Grove - Canyonville
Zone

Comp. Decline. 14'14" E
Agency DCSO
Party Chief S. Fause
Note keeper
Witnesses J. Korsung

N 155 989.228
E 273 806.967

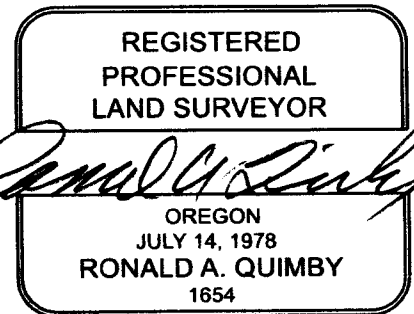

EXPIRES: 12/31/2024

CS 67/58-42

RENEWED
7/29/24

FILED

Date: 2/1/2001 By: JP

This survey consists of:

Map: M132-70

Narrative:

Corner Rpt: CS 65/36-2G

OREGON CORNER RESTORATION FORM

Section 34 Township 26S Range 2W

County Douglas Date Jan. 24, 2001

Corner Designation

CS 1/16

DOUGLAS COUNTY
SURVEYOR
DECLINATION 14 1/4° E

- Condition Report Only
- Not Found
- Renewed
- Unrecorded
- Surveyed In
- Referenced Out

Previous Renewals/Surveys, etc. OCRS CANYONVILLE COTTAGE GROVE COORD.S


None. 185989.228
273806.967

Monument(s) & Accessories Found: (Condition and Source)

MON. BELOW ~~None~~ FOUND UNDER LARGE BURNED ROOTWAD
ROOTWAD ROLLED AWAY TO REVEAL BURIED COR. MONUMENT

Monument Detail

Sketch

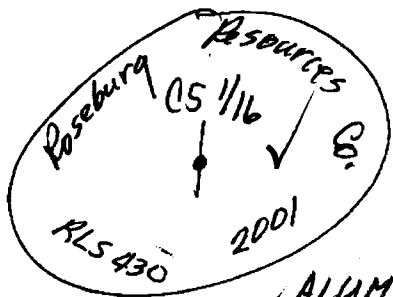

MONUMENT IS ON EAST EDGE
OF A SMALL BENCH ON A MODERATE
WESTERLY SLOPE. OLD GROWTH IN SW
QUADRANT, REPROD IN SE QUAD.
CLEARCUT TO NORTH

ALUMINUM CAP IS BENT AND DISTORTED BUT
IS FULLY LEGIBLE, IRON ROD LEANING - RETURNED TO PLUMB

Monument Set (Procedures and Description)

I set a 3/4" x 40" Iron Rod with a 2 1/2" Alum. Cap. FOUND BURIED 4"
from which a: REMOVE SOIL NOW PROT. 3"

NEW REF. LIVE 5" D. FIR SCAIRED "X" "BT" ON HIGH LOW BLZ. S56°W, 24 1/2

New Accessories

SAWN BURNED
ROTTED STUMP

12" x 6 FT 12" D. Fir BT, I scribed "CS 1/16 BT" bears N39°W, 81 feet
FACE GONE

26" x 22" D. Fir BT, " FULLY HEALED BLAZE bears S85°W, 23 1/2 feet. S88°W, 24 1/2
6 Foot Steel Fence Post bears West, 12 feet. FOUND BENT OVER -
" " " " " " South, 12 feet.

ADD 3 1/2" MAGNOLIA R.S.C.

Location & Comments

Surveyor's Seal STRAIGHTEN UP

Compass Declination 20°E

Firm/Agency Shaner

Engineering

Address P.O. Box 1430

Roseburg, Oregon 97470

Party Chief B. Shaner

Notes " "

Witness Claude McLean

REGISTERED
PROFESSIONAL
LAND SURVEYOR

Bruce A. Shaner

OREGON
OCT. 4, 1967
BRUCE A. SHANER
430

CS 67/58-42

Ron Schneider

Renews Jan 30,

C.S. File No. 65/36-2G 2002

MIN. 511
43.26097
122.92170