

GOVERNMENT CORNER RESTORATION FORM

FILED

TOWNSHIP 26S RANGE 2W SEC. 9

PLSS # 340526 Date: 8/19/2024 By: [Signature]

This survey consists of:

DOUGLAS COUNTY OREGON

DATE 8-5-24

Map: _____

Narrative: _____

Corner Rpt: CS 67/58-43

Corner Designation

CS 1/16 29

DOUGLAS COUNTY SURVEYOR

Monument(s) Found: (Condition and Source)

___ Condition report

___ Not Found

Renewed

___ Unrecorded

___ Surveyed In


3 1/4" BLM BRASS CAP

UP 2"

Previous Renewals

BLM 1979 1/6/42 pg 16943

MONUMENT DETAIL

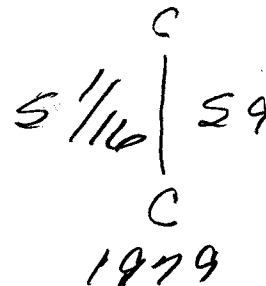

Accessories Found

BURNED - DEAD 27" D. FIRE N 28° E 12.4 FT
(REC N 22 1/2° E 20 LKS) ADD 3 1/2" MAG
NAIL RIGHT SIDE CENTER

BURNED - SAWN 18" X 2 FT Hemlock STUMP
N 14° W 13.2 FT (REC 21 LK) VISIABLE SCAR
IN LOG PILE NOT GOOD REFERENCE

C.S. File 67/58-43

New Accessories

1/8" X 30" Iron Rod with DCSD
plastic cap up 4" S 79° E 16.8 FT
set in west edge of westerly road
shoulder

Sketch of Monument, Accessories, and General Area

Location & Comments

MON ON steep WNW slope
S.W. QUADR. IS CLEARCUT
Rest IS BURNED PARTLY CLEARED
Forest
OGRS COORDINATE SYSTEM
COTTAGE GROVE - CANYONVILLE
ZONE


MON IS 25 FT
WEST OF GRAVEL
ROAD

AREA BURNED
9/2020

Comp. Decline. 14 1/4° E
Agency DCSD
Party Chief S. F. HAUSE
Note keeper
Witnesses J. LORSUNG

N 176426.032
E 268198.464

CS 67/58-43
217

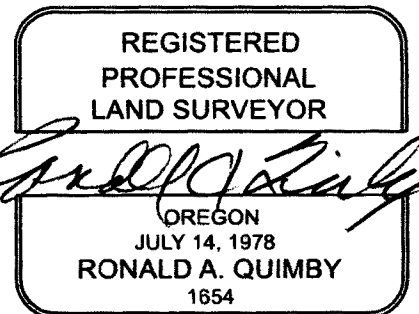

EXPIRES: 12/31/2024