

GOVERNMENT CORNER RESTORATION FORM

FILED

TOWNSHIP 26S RANGE 2W SEC. 27

PLSS # 400273

Date: 8/19/2024 By: SC

This survey consists of:

DOUGLAS COUNTY OREGON

DATE 8-6-24

Map: _____

Narrative: _____

Corner Rpt: CS 67/58-44

DOUGLAS COUNTY SURVEYOR

Corner Designation 22

CC 27/28 only

Monument(s) Found: (Condition and Source)

2 1/2" GLD BRASS CAP
UP 10"

___ Condition report

___ Not Found

Renewed

___ Unrecorded

___ Surveyed In

Previous Renewals

GLD 1916-1918 Vol 10 pg 4329-30
DCSO 1967 CS 54/40-60
EDWARDS 2004 M 143-66

MONUMENT DETAIL

T26S R22W
S22
S28 | S27
CC
1918

Accessories Found

BURNED Broken 12" x 6' FT D FIR SWAG
S86'S E 25.8 FT Fully Heated Single
BLAZE ADD 3 1/2" MAG NAIL RIGHT SIDE
Center

2 metal Post 1 Foot South
2 Feet West

New Accessories

BURNED SAWN - 32" X 2 FT D. FIR STUMP
N56°E 9.2 FT 3 1/2" MAG NAIL
TOP CENTER

Sketch of Monument, Accessories, and General Area

Location & Comments


MON IN BURNED OVERYOUNG
Reprod unit on steep NINE
Slope approx. 150' North of
GRAVEL ROAD

AREA BURNED
9/2020

OCRS COORDINATE SYSTEM
COTTAGE GROVE - CANYONVILLE
ZONE

Comp. Decline. 14 1/4° E
Agency DCSO
Party Chief G. F. HAUSE
Note keeper
Witnesses J. LORSUNG

N 164785.760 N
E 271186.098

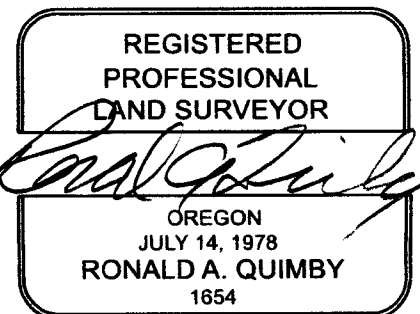

EXPIRES: 12/31/2024

CS 67/58-44 2/3