

GOVERNMENT CORNER RESTORATION FORM

FILED

TOWNSHIP 26S RANGE 2W SEC. 34 PLSS # 460120

Date: 8/19/2024 By: X

This survey consists of:

DOUGLAS COUNTY OREGON

DATE 8-7-24

Map: \_\_\_\_\_

Narrative: \_\_\_\_\_

Corner Rpt: CS 67/58-75

Corner Designation

SE 1/16 S 34

DOUGLAS COUNTY SURVEYOR

Monument(s) Found: (Condition and Source)

2 1/2" Alum. CAP ON 3/4" IRON ROD 4P 17" ADD ROUGH STONE MOUND

Condition report

Not Found

Renewed

Unrecorded

Surveyed In

Previous Renewals

SHANER 2001 SET IN 132-70 & CS 65/36-2 I

MONUMENT DETAIL

Roseburg Resources CO.

SE 1/16

RLS 430

2001

Accessories Found

BURNED DEAD 14" MADRONE N20W 2.0 FT BARK GONE ADD 3 1/2" MAG NAIL RIGHT SIDE CENTER

BURNED ROTTED 25" X 6 1/2 FT FIR STUMP S40W 23.1 FT (REC S40E 23.6 FT) BLAZE

BURNED AWAY ADD 3 1/2" MAG NAIL LEFT SIDE CENTER

6' Alum post EAST 1 FT

C.S. File 67/58-45

Monument Set (Procedure and Description)

MONUMENT DETAIL

Blank lines for Monument Set description.

New Accessories

Blank lines for New Accessories description.

Sketch of Monument, Accessories, and General Area

Location & Comments

MON IS ON moderate steep SW slope in MIXED GRASSLAND AND FIR FOREST  
OGRS Coordinate System  
Cottage Grove - Canyonville Zone

MON IS APPROX 140 FT NORTH OF GRAVEL ROAD

AREA BURNED 9/2020

Comp. Decline. 14 1/4° E  
Agency DCSO  
Party Chief S. Clause  
Note keeper  
Witnesses J. Loring

N 156027.627  
E 275650.308

CS 67/58-45  
213



EXPIRES: 12/31/2024

FILED

Date: 2/1/2001 By: P

This survey consists of:

Map: M132-70

Narrative: \_\_\_\_\_

Corner Rpt: CS 65/36-23


OREGON CORNER RESTORATION FORM

Section 34 Township 26S Range 2W

County Douglas Date JAN. 24, 2001

DOUGLAS COUNTY SURVEYOR

Corner Designation

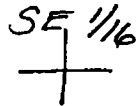

- Condition Report Only
- Not Found
- Renewed
- Unrecorded
- Surveyed In
- Referenced Out

RENEWED 8/17/24

Previous Renewals/Surveys, etc. \_\_\_\_\_

None.

DECLINATION 14 1/4° E

Monument(s) & Accessories Found: (Condition and Source)


None.

DCRS CANYONVILLE COTTAGE GROVE CORNERS

156027.627 N  
275050.308 E

Monument Detail

Sketch

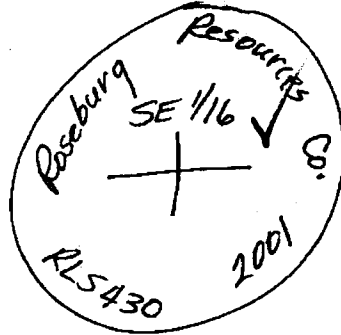

ALUMINUM LATH ON EAST EDGE.

Monument Set (Procedures and Description)

I set a 3/4" x 3/8" Iron Rod with a 2 1/2" Alum. PROT. 17"  
Cap, from which a: ADD ROUGH MOUND OF STONE  
AROUND BASE

New Accessories

18" Madroña BT, I/bark scribed "SE 1/16 BT,"  
bears N2°W, 2 1/2 feet.  
36" D. Fir BT, I scribed "SE 1/16 BT," bears PLATE  
504° W 23 1/2 feet. 23 1/2 FT  
6 Foot Alum. Post bears East, 12 feet. ADD 3 1/2" MAG NAIL L.S.C.

Location & Comments

Corner 1/16  
40 feet below  
small bluff.

Compass Declination 20° E

Firm/Agency Shaner

Address Engineering

Address P.O. Box 1430

Party Chief Roseburg, Oregon 97470

Notes " "

Witness Ben Schneider

Gregg Donskine

C.S. File No. 65/36-23

REGISTERED PROFESSIONAL LAND SURVEYOR

Bruce A. Shaner

OREGON OCT. 4, 1987 BRUCE A. SHANER 430

Renews June 30, 2002

MINI 5/15  
43.26097  
122.91680

BURNED DEAD 14"  
SAWN BURNED ROTTED  
25" X 6 1/2 FT. STUMP 504° W

MONUMENT IS ON MODERATELY STEEP SW SLOPE IN MIXED GRASSLAND AND FIR FOREST, MONUMENT IS APPROX 140 FT. NORTH FROM GRAVEL RD.

CS 67/58-45  
313