

GOVERNMENT CORNER RESTORATION FORM

TOWNSHIP 24S RANGE 2W SEC. 34 PLSS # 440140

FILED
Date: 8/19/2024 By: X

This survey consists of:

DOUGLAS COUNTY OREGON

DATE 8-7-24

Map: _____

Narrative: _____

Corner Rpt: CS 67/58-46

DOUGLAS COUNTY
SURVEYOR

Corner Designation

C 1/4 S34

Monument(s) Found: (Condition and Source)

2 1/2" Alum Cap 0 1" O.D.
Iron pipe up 18" ADD
Rough mound of Stone

___ Condition report

___ Not Found

Renewed

___ Unrecorded

___ Surveyed In

Previous Renewals

Shrum set 1979 in 76-56
SHRUM 2001 CS 65/36-214
AND N1132-70

MONUMENT DETAIL

T26 R2W
C 1/4
SEC. 34
1978
REF 4287

Accessories Found

BURNED DEAD 5" W. OAK N190E 15.3 FT

BURNED DEAD 5" W. OAK FALLEN OUT OF POSITION

2 4' ALUM post N60W 1 FT
N30E 1 FT

New Accessories

5/8" X 30" Iron Rod with DCSO plastic
Cap N 42° E 10.0 FT up 5"

5/8" X 30" Iron Rod with DCSO plastic
Cap N 46° W 7.9 FT up 5"

Sketch of Monument, Accessories, and General Area

Location & Comments

MON ON moderate steep
GRASSY west slope with
scattered patches BURNED
LARGER Fir & Cedar
OGRS Coordinate System
Cottage Grove - Canyonville
Zone


MON IS APPROX 200
FT NNW OF WEST
END OF GRAVEL
SPUR ROAD

AREA BURNED
9/2020

Comp. Decline. 1474° E
Agency DCSO
Party Chief S. F. HAUSE
Note keeper
Witnesses J. LORSUM

N 157280.398
E 273833.064

CS 67/58-46
213

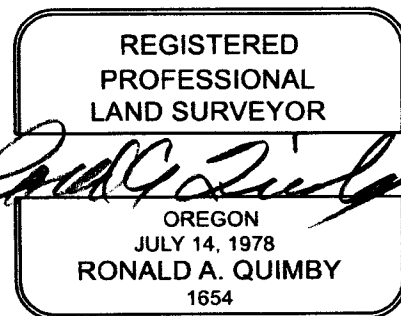

EXPIRES: 12/31/2024

TOWNSHIP 26 RANGE 02 POINT IDENTIFIER # 440140

PRIMARY CORNER DESCRIPTION Center 1/4 Cor. Sec. 34 **RENEWED 8/7/24**

Alias _____ Description _____
 Alias _____ Description CCRS CANYONVILLE COTTAGE GROVE COORD'S
 Alias _____ Description _____
 Alias _____ Description 157280.398 N
273833.064 E

Thomas E. Shrum Jr. - For: Champion International Co. - Feb. 1, 1979 - M76-56

Set - 2 1/2" alum cap. ON 1" O.D. I.P. (MARKED AS BELOW) ADD ROUGH MOUND OF STONE **PROT 18"**
 BTs - 5" W.Oak bears ~~S. 33° E., 12.7 ft.~~ **FALLEN OUT OF POSITION**
 5" W.Oak bears N. 19° E., 15.3 ft.

Fd. Ok by B. Shaner, 1/2001 - C.S. File 65/36-2H & M132-70
Added 2 6 ft. Alum. post ~~West~~ 1 ft. & ~~East~~ 1 ft.

N60°W N30°E

NEW REFS.

5/8" x 30 IRON ROD / PLASTIC CAP	SET	PROT 5"	N42°E, 100
" " " "	"	"	N46°W, 79

FOUND ALUM. CAP MARKED T26 R2W RE 4287
 C 1/4
 SEC. 34
 1978

MONUMENT ON MODERATELY STEEP GRASSY WEST SLOPE WITH SCATTERED PATCHES BURNED LARGER FIR AND CEDAR.
 MONUMENT IS APPROX. 200 FT. NNW FROM WEST END OF GRAVELLED SPUR ROAD.

BURNED DEAD
" "

MINI GIS
43,26446
122,92161

CS 67/58-46
3/3