

GOVERNMENT CORNER RESTORATION FORM

FILED

TOWNSHIP 26S RANGE 2W SEC. 28

PLSS # 300200

Date: 8/21/2024 By: X

This survey consists of:

Map: _____

Narrative: _____

Corner Rpt: CS 67/58-48

DOUGLAS COUNTY OREGON

DATE 8-12-24

DOUGLAS COUNTY SURVEYOR

Corner Designation

Sec COR 29/28
32/33

Monument(s) Found: (Condition and Source)

2 1/2" Alum CAP ON 3/4"
IRON PIPE UP 10"

___ Condition report

___ Not Found ¹

Renewed

___ Unrecorded

___ Surveyed In

Previous Renewals

Nygren 1999 (Filed 4-2010) CS 65/70-3
Edwards 1995 CS 65/25-4
DCSO 2010 CS 67/31-8
BLM Resurvey 2011 Vol 58 pg
22931

MONUMENT DETAIL

U S P C Property
COR
29/28
32/33
RE 4287

Accessories Found

Decayed Hemlock Stump N48°E 47.5 FT
Decayed Hemlock SAWN Stump S21°E 13.9 FT
Rotted Root Crown Hemlock S52°W 26.4 FT
Very Decayed SAWN 30" x 2 FT Hemlock Stump
S55°W 25.4 FT BLAZE GONE
27" R. Cedar N31°W 75.0 FT open Double BLAZE
14" D. Fir N1 1/2°W 7.8 FT Fully Healed
Double BLAZE
12" x 20 FT Hemlock S53 1/4°W 26.4 FT (Rec
25.9 FT) scribe MARKS visible on open
Double BLAZE
12" D. Fir N33°W 42.6 FT Fully Healed
Double BLAZE
Calu post 1.7 FT west
ADD 3 1/2" MAG Nail RIGHT Side Center
To ALL standing trees

C.S. File 67/58-48

Found cont.

RENEWAL

Monument Set (Procedure and Description)

MONUMENT DETAIL

11" Hemlock S 43 3/4° E 13.3 ft (rec 13.4)

New Accessories

Sketch of Monument, Accessories, and General Area

Location & Comments

OCRS Coordinate System
Cottage Grove - Canyonville
zone

N 159987.005
E 265900.453

Mon on slight N.W.
Slope Clearcut
S.W. Quad Rest
Old Regrowth

AREA BURNED

9/2020

Comp. Decline. 14 1/4° E


Agency DCGO

Party Chief S. F. KAUSE

Note keeper

Witnesses J. LORSHUG

CS 67/58-48
2/4

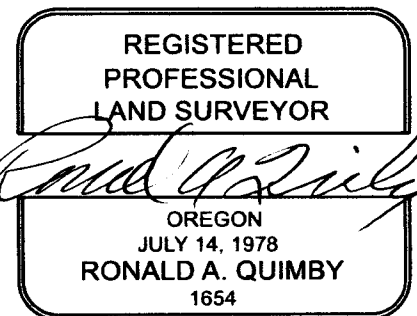

EXPIRES: 12/31/2024

PRIMARY CORNER DESCRIPTION Cor Secs 28, 29, 32, & 33

Alias _____	Description _____
Alias _____	Description _____
Alias _____	Description _____
Alias _____	Description _____

- 27" dia., R.Cedar scribing visible on an open double blazed "S29 BT" bears N.26°W., 75.0 ft. (1972 BT Tag by Agee (see renewal sheet for symbol) ? brg & dist on tag S.28°E., 75.0 ft.) (Silver tag on blaze marked RE 4287)
 - 11" dia., Hemlock with scribing visible on a partially healed double blaze "SEC COR S32 BT" bears S.58°W., 25.7 ft. (1999 BT tag by GVN, brg & dist on tag N.54°E., 26.0 ft.)
 - 7" dia, Hemlock with scribing visible on a partially healed double blaze "X BT" bears S.38½°E., 13.3 ft (1999 BT tag by GVN brg & dist on tag N.40°W. 13.30 ft)
 - 11" dia., D.Fir with scribing visible on a partially healed double blaze, "28 SEC" bears N.4°E., 7.7 ft. (1999 BT tag by GVN brg & dist on tag S.2°W., 7.75 ft.)
 - 8" dia., D.Fir with scribing visible on a partially healed double blaze "SEC COR" bears N.28°W., 42.6 ft. (1999 BT Tag by GVN brg & dist on tag S.30°E., 43 ft.)
- Note: All BT tags on above trees marked T27S not T26S - First two BTs have identical style of scribing.
- 18" now rotted remains of a hemlock bears N.54°E., 47.5 ft. orig. rec. (N.48°E., 47.5 ft.)
 - 10" now 30" dia., 3 ft. high hemlock stump bears S.21°E., 12.6 ft. orig. rec. (S.21°E., 13.9 ft) We did not open.
 - 6" now rotted remains of a hemlock bears S.52°W., 22.2 ft. orig. rec. (S.52°W., 26.4 ft.)

No evidence of orig. NW BT found falls in cat road.
 Note - Received a copy of an unrecorded survey by Gerald Nygren that David Edwards recently acquired from Seneca Jones Timber Co. now filed as C.S. File 65/70-3 on 4-15-2010
 Compass decl. 16½°E.

BLM Dependent Resurvey by Kenneth W. Saveland, Cadastral Surveyor, under Group No. 2331, Surveyed April/Oct. 2011 - (DCSO records Vol. 58 Page(s) 22931)

The cor. of secs. 28, 29, 32, and 33, perpetuated by person(s) unknown, subsequently perpetuated by Nygren, in 1999, monumented with an iron post, 1" dia., firmly set, projecting ~~14"~~ ^{10"} above ground, with an aluminum cap (properly) mkd.

SEE NEXT PG FOR MARKS

- from which the remains of original bearing trees
- A ✓ decayed hemlock stump, size indeterminate, bears N.48°E., 47.5 ft., with a fallen, decayed hemlock snag, size indeterminate, lying alongside, with no marks visible on stump or snag.
 - A ✓ sawed, decayed, hemlock stump, 38" dia., bears S.21°E., 13.9 ft., with no marks visible. continued next pg

TOWNSHIP 26 RANGE 02 POINT IDENTIFIER # 300200

PRIMARY CORNER DESCRIPTION Cor Secs 28, 29, 32, & 33 RENEWED 8/12/24

Alias _____ Description DECLINATION 14 1/4° E
Alias _____ Description _____
Alias _____ Description _____
Alias _____ Description _____

SEE PG 2 ALSO ADD 3 1/2" MAG NAIL R.S.C. TO ALL STANDING B.T.'S

ROTTED ROOT CROWN

VERY DECAYED 30" X 2 FT

A decayed hemlock stump, size indeterminate, bears S.52 1/4 W., 26 1/4 ft., with no marks visible.

and the remains of bearing trees mkd. by person(s) unknown
A sawed hemlock stump, 43" dia., bears S.55° W. 35.4 ft., with scribe marks S32 BT RE 4287 visible on an open blaze. BLAZE GONE

27" AR cedar, 26" dia., bears N.31° W., 75 1/0 ft., with scribe marks S29 BT on upper and RE4287 visible on lower open double blaze.

and bearing the trees mkd. by Nygren
14" AD fir, 11" dia., bears N.1 1/2° W., 7.8 ft., no marks visible on a partially healed blaze. FHDB

11" A hemlock, 9" dia., bears S.43 3/4° E., 13.4 ft., with a healed double blaze. 3

12" x 2 FT. A hemlock, 12" dia., bears S.53 1/4° W., 26 1/2 ft., with scribe marks SEC COR S32 on upper and BT visible on lower open double blaze. 26 1/2

12" AD fir, 9" dia., bears N.33° W., 42 1/6 ft., with fragmentary scribe marks visible on a partially healed double blaze. FHDB

FOUND GALVANIZED LATH 1 1/2 FT. WEST

Fd. Ok by R. Rice, 5/2013 - C.S. File 65/79-9

OAS CANYONVILLE COTTAGE GROVE COORDS

159987.005 N

265900.453 E

2 1/2" ALUM. CAP MARKED

U.S. P.C. PROPERTY COR.

NEW S 1/2 T 29 | 28
32 | 33

R.E. 4287

CS 62/58-48
414

MONUMEN ON SLIGT NW SLOPE, CLEAR-CUT SW QUAD.
REST OLD REGROWTH.