

GOVERNMENT CORNER RESTORATION FORM

FILED

TOWNSHIP 26S RANGE 2W SEC. 27

PLSS # 46208 Date: 8/13/2024 By: X

This survey consists of:

DOUGLAS COUNTY OREGON

DATE 8/13/24

Map: _____

Narrative: _____

Corner Rpt: CS 67/58-49

Corner Designation

E 1/4 27/34

DOUGLAS COUNTY SURVEYOR

Monument(s) Found: (Condition and Source)

Condition report

Not Found

Renewed

Unrecorded

Surveyed In

2 1/2" ALUM CAP ON 1"
IRON ROD UP 14"

Previous Renewals

Shrum Set 1978 - M76-56
BLM RENEWAL Vol 58 pg 22928

MONUMENT DETAIL

T26S 22W
RE 4287

E 1/4 527
1/6 534
1978

Accessories Found

28" E CEDAR BURNED BASE X136 1/2° E 9.9 FT
HEALED DOUBLE BLAZE ADD 3 1/2" MAG NAIL
RIGHT SIDE CENTER

SAWN BURNED 25" ^{XUSA} FIRE STUMP 539 1/4° W
59.5 FT HEALED BLAZE ADD 3 1/2" MAG
NAIL RIGHT SIDE CENTER

New Accessories

SAWN BURNT 20" X 2 FT Hemlock Stump
N 86° E 2.4 FT 3 1/2" MAG NAIL TO
Center

ADD Rough Mound of stone AROUND
Iron Rod

Sketch of Monument, Accessories, and General Area

Location & Comments

MON. ON Moderate, Changing
to steep, South Slope on
North Edge of GRASSY CLEARCUT
old Reprod to North


AREA BURNT
9-2020

DCRS COORDINATE SYSTEM
Cottage Grove - Canyonville
Zone

Comp. Decline 14 1/4° E
Agency DCSO
Party Chief S. F. AUSE
Note keeper
Witnesses J. LORSUNG

N 159974.294
E 275120.357

CS 67/58-49

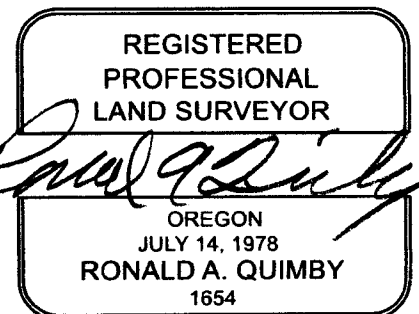

EXPIRES: 12/31/2024

Vol 58

22928

Dependent Resurvey of a Portion of the Subdivisional Lines
T. 26 S., R. 2 W., Willamette Meridian, Oregon

The 1/4 sec. cor. of secs. 27 and 34, perpetuated by the Douglas County Surveyor's Office in 1967, monumented with an iron post, 1 in. diam., firmly set, projecting 5 ins. above a collar of stone, with brass cap mkd.

1/4 S 27

1/4 S 34
1918

from which the remains of bearing trees mkd by Mensch

A sawed, decayed, hemlock stump, 16 ins. diam., bears S. 10° E., 4.6 ft. dist., with a healed double blaze.

A roothole bears N. 17° W., 10.6 ft. dist., with a fallen, decayed, hemlock snag, size indeterminate, lying alongside, with no marks visible.

and the remains of a bearing tree mkd. by the Douglas County Surveyor's Office

A sawed, decayed, hemlock stump, size indeterminate, bears N. 51 1/2° E., 15.3 ft. dist., with fallen, decayed hemlock trunk segment lying alongside, size indeterminate, with scribe marks 1/4 S27 CS BT visible on a partially healed blaze.

and new bearing trees

A fir, 10 ins. diam., bears N. 13 1/2° E., 23.2 ft. dist., mkd. 1/4 S27 BT.

A cedar, 5 ins. diam., bears S. 53° E., 17.1 ft. dist., mkd. 1/4 S34 BT.

Corner is located 25 ft. N. of a gravel road, 12 ft. wide, bears N. 70° W. and S. 85° E., in a curve.

460200 DECLINATION 14° E

The E 1/16 sec. cor. of secs. 27 and 34, established by Shrum, PLS No. 1706, in 1979 by proportionate measurement, and is accepted as the cor.; monumented with an iron post, 1 in. diam., firmly set, projecting 14 ins. above ground, with brass cap mkd.

OGRS CANYONVILLE COTTAGE GROVE COORDS
159974.294N
275120.357E
2 1/2" ALUMINUM CAP
T 26 S R 2 W RE 4287
S 27
E 1/16
S 34
1978

PROT 14"

ADD ROUGH MOUND OF STONE AROUND IRON POST

from which the bearing trees mkd. by Shrum

INCENCE
ALIVE BURNED BASE 28" I cedar, 27 ins. diam., bears N. 36 1/2° E., 9.9 ft. dist., with two healed double blazes.

ADD 3 1/2" MAG NAIL R.S.G.

BURNED SAUN 25" x 6 FT STUMP A fir, 20 ins. diam., bears S. 39 1/4° W., 54.5 ft. dist., with a healed blaze.

ADD 3 1/2" MAG NAIL R.S.G.

NEW REFERENCE

BURNED SAUN HEMLOCK STUMP 20" x 2 FT N 86 1/2° E, 2 # 3 1/2" MAG NAIL TOP CORNER

MONUMENT ON MODERATE, CHANGING TO STEEP, SOUTH SLOPE
MONUMENT ON NORTH EDGE OF GRASSY CLEARCUT, OLD REPROD. TO NORTH,
FIR, CEDAR, HEMLOCK

CS 67/58-47

3/3

MINI GIS
43.27151
122.91649

8/13/24
76-50
M
BLW
2011