

GOVERNMENT CORNER RESTORATION FORM

FILED

TOWNSHIP 26S RANGE 2W SEC. 26 PLSS # 500220

Date: 8/21/2024 By: X

This survey consists of:

Map: _____

DOUGLAS COUNTY OREGON

DATE 8-13-24

Narrative: _____

Corner Rpt: CS 67/58-56

Corner Designation

S 1/16 S 24

DOUGLAS COUNTY SURVEYOR

Monument(s) Found: (Condition and Source)

3/4" BRASS TABLET IN
ROCK OUT CROP

___ Condition report

___ Not Found

Renewed

___ Unrecorded

___ Surveyed In

Previous Renewals

BLM SET IN 2011
Vol 58 pgs 22925-6

MONUMENT DETAIL

S 1/16
S 26
2011

Accessories Found

27" BURNED - DEAD D. FIR SNAG N14°E
21.8 FT (REC 21.5 FT) PARTLY HEALED
SINGLE BLAZE ADD 3 1/2" MAG NAIL
RIGHT SIDE CENTER

BURNED SAWN 11" X 3 FT D. FIR STUMP
S 50 1/2° E 25.1 FT HEALED LOWER BLAZE
ADD 3 1/2" MAG NAIL RIGHT SIDE CENTER

ALUM. POST 1/2 FT WESTERLY

C.S. File 67/58-50

Monument Set (Procedure and Description)

MONUMENT DETAIL

New Accessories

Sketch of Monument, Accessories, and General Area

Location & Comments


OCRS COORDINATE SYSTEM
COTTAGE GROVE - CANYONVILLE
ZONE

N 160114.378
E 275836.392

Area burnt
9/2020

Comp. Decline. 14 1/2° E
Agency DCSO
Party Chief S. FRAUSE
Note keeper
Witnesses J. LORSUNG

CS 67/58-50
2/3

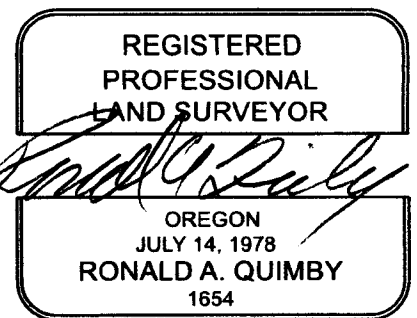

EXPIRES: 12/31/2024

TOWNSHIP 26 RANGE 02 POINT IDENTIFIER # 500219 500220

PRIMARY CORNER DESCRIPTION S 1/4 S 26 ~~CC Secs. 27 & 34 (SE Cor. Sec. 27)~~

Alias _____	Description _____	RENEWED 8/13/24
Alias _____	Description _____	
Alias _____	Description _____	
Alias _____	Description _____	

DECLINATION 14 1/4° E

T26S, R2W, 500220

Cement a brass tablet, 3 1/2" dia., with 2 1/2" stem, in a drill hole, in a rock outcrop, (deposit a magnet in drill-hole beneath stem) with cap mkd. **AS DESCRIBED**

FIND AN ALUMINUM LATH | S 1/16
≈ 1/2 FT. WESTERLY | S 26
2011

**BOTH FOUND B.T.S
HAVE MAG NAIL R.S.C.
PH SB**

from which

AD, fir, 26" dia., bears N. 14° E., 21.5 ft., mkd. S 1/16 S 26 BT

AD, fir, 11" dia., bears S. 50 1/2° E., 25.1 ft., mkd. ~~X BT~~ **HEALED LOW BLAZE**

Corner is located 3 ft. N. of the southerly edge (bottom) of a rock outcropping, 10 ft. high, edge bears N. 70° E. and S. 70° W.

DCRS CANYONVILLE COTTAGE GROVE COORD.S

160114.378 N

275836.392 E

**SNAG
BURNED DEAD 27"
BURNED SAWN
10" X 3" STUMP**

CS 67/58-50

3/3