

GOVERNMENT CORNER RESTORATION FORM

FILED

TOWNSHIP 265 RANGE 3W SEC. 24

PLSS # 640300

Date: 8/21/2024 By: X

This survey consists of:

Map: _____

Narrative: _____

Corner Rpt: CS 67/58-52

DOUGLAS COUNTY SURVEYOR

DOUGLAS COUNTY OREGON

DATE 8-20-24

Corner Designation

1/4 COR 24/25

Monument(s) Found: (Condition and Source)

___ Condition report

___ Not Found

Renewed

___ Unrecorded

___ Surveyed In

DCSO 2 1/2" BRASS CAP
BENT - REPLUMEN ADD
ROUGH MOUND OF STONE

Previous Renewals

DCSO 1957 CS 47/190
Calder 1960 CS 51/87-2
DCSO 1979 CS 60/24-32
Geisler 1984 CS 58/146-2
BLM Rehab 2004 Vol 55 pg 21449
BLM Resurvey 2009 Vol 57 pg 22697
EDWARDS 2012 M 164-32

MONUMENT DETAIL

T 26S R 3W

1/4 S24
S25

1957

County Surveyors
OFFICE

Accessories Found

BROKEN BURNED - ROTTED 28" X 1 1/2 FT FIR STUB
N100E 16.9 FT

BURNED - DEAD 24" FIR N890E 3.3 FT HEALED
DOUBLE BLAZE

BURNED - DEAD BARK GONE 17" PINE S780E
31.7 FT

BURNED - DEAD BARK 1/2 GONE 19" I. CEDAR
S 33 1/4 W 73.7 FT WITH HEALED BLAZE

RENEWAL

Monument Set (Procedure and Description)

MONUMENT DETAIL

Blank lines for Monument Set (Procedure and Description)

New Accessories

Blank lines for New Accessories

Sketch of Monument, Accessories, and General Area

Location & Comments


MON ON STEEP N.W. slope
Very old Regrowth to West
Clearcut to East

AREA BURN
9-2020

BCRS COORDINATE SYSTEM
COTTAGE GROVE - CANYONVILLE
ZONE

Comp. Decline. 14'14"E
Agency DCSO
Party Chief S. F. Hulse
Note keeper
Witnesses J. Larsung

N 145138.247
E 252783.567

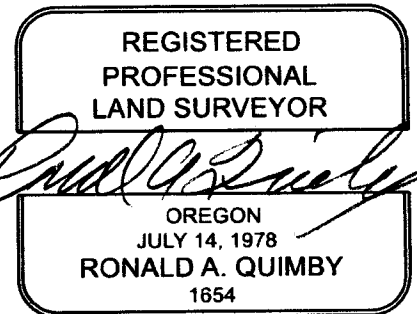

CS 67/58-52
213

TOWNSHIP 26 RANGE 03 POINT IDENTIFIER # 640300

PRIMARY CORNER DESCRIPTION 1/4 Cor for Secs 24 and 25

Alias _____	Description _____
Alias _____	Description _____
Alias _____	Description _____
Alias _____	Description _____

20" Fir now 34", bears N.10°E., 19.9 ft. to center (Rec. N.40°E., 15.2 ft.) Traces of bark scribing. (Orig.)
 Root crown bears S.10°E., 9.9 ft. with a down Fir alongside, "BT" visible. (Orig.)
 10" S.Pine now 14", bears S.78°E., 31.9 ft. with healed blaze.
 12" Fir now 18" bears N.89°E., 3.3 ft. with well healed blaze.
 No new monument set.
 New BT - 25" trunk of a triple trunk Cedar bears S.34°W., 85.7 ft. with scribing "1/4 S25 CS BT" in a double blaze.

Found Brass cap & 4 BTs. - Ronald Geisler, Feb. 1, 1984
C.S. File 58/146-2

Fd. & used on BLM rehabilitation of certain corners, Timothy J. Moore, Cadastral Surveyor & Robert H. Browning, Surveying Tech., under Group #2100, & 2300, Surveyed April/May 2004, - (DCSO records Vol. 55 Page(s) 21499) See 2008 BLM plat.
DECLINATION 14 1/4° E *RENEWED 8/20/24*

BLM Dependent Resurvey by A Bert Skeesick, Cadastral Surveyor and Robert H Browning, Survey Tech, Under Group No. 2268, Surveyed July/Nov. 2009 - DCSO records Vol. 57 Page(s) 22697

MONUMENT FOUND AS DESCRIBED BUT LEANING 1 1/2 FT. SW
REPLUMB AND ADD ROUGH RING OF STONE
BROKEN BURNED ROTTED 28" x 1 1/2 FT. STUB GONE
BURNED DEAD 24" A
BURNED DEAD BARK GONE 17"
BURNED DEAD 19" A 1/2 BARK GONE

The 1/4 sec. cor. of secs. 24 & 25, perpetuated by Reed, in 1979, monumented with an iron post, 1 1/4" dia., firmly set, projecting 20" above the ground, w/brass cap (properly) mkd. from which the remains of the original bearing trees:
 A fir, 32" dia., bears N.10°E., 16.9 ft., with a healed blaze. (Record, 15.2 ft.)
 A decayed fir stump, size indeterminate, bears S.10°E., 9.9 ft., with no marks visible.
 and the remains of BTs mkd. by James W. Byron, in 1957
 A fir, 22" dia., bears N.89°E., 3.3 ft., with a healed double blaze
 A pine, 19" dia., bears S.78°E., 31.7 ft., with a healed double blaze.
 and a bearing tree mkd. by Reed
 A cedar, 21" dia., bears S.33 1/4°W., 73.7 ft., with a healed blaze
 Corner is located 60 ft. W. of a dirt road, 10 ft. wide, bears N.20°W. and S.20°E.
 Latitude: 43°17'09.13"N. Longitude: 123°00'00.17"W.
 (NAD 1983 (CORS))

Cont.

MONUMENT ON STEEP NW SLOPE VERY OLD REGROWTH TO WEST CLEARCUT TO EAST.

CCRS CANYONVILLE COTTAGE GROVE COORD, S 165138.248N 252783.567E

CS 67/58-52 2 313