

GOVERNMENT CORNER RESTORATION FORM

FILED

TOWNSHIP 255 RANGE 2W SEC. 28 PLSS # 340200

Date: 9/23/2024 By: SC
This survey consists of:

DOUGLAS COUNTY OREGON

DATE 8-21-24

Map: _____
Narrative: _____
Corner Rpt: CS67/58-55

Corner Designation

1/4 COR 28
33

DOUGLAS COUNTY
SURVEYOR

Monument(s) Found: (Condition and Source)

BLM BRASS CAP UP
2" IN COLLAR OF STONE

- Condition report
- Not Found
- Renewed
- Unrecorded
- Surveyed In

Previous Renewals

BLM RESURVEY 1962 Vol 32 pg 13230
BLM RESURVEY 2014-2015
Vol 58 pgs 23339-40

MONUMENT DETAIL

1/4 528
533
T 255 R2W
1962

Accessories Found

BURNED - DEAD 42" D. FIR S25°E 5.0 FT
HEALED SINGLE BLAZE

VERY ROTTED AND BURNED 25" X 3 1/2 FT FIR
STUMP N 40 1/2° W 33.0 FT BLAZE GONE

BURNED - DEAD 7" D. FIR N 21 1/4° E 31.5 FT
UPPER BLAZE BURNED OUT LOWER BLAZE
HEALED

STEEL FENCE POST EAST 1.9 FT

C.S. File 67/58-55

New Accessories

Burnt-Dead 43" School MARM D. Fir
S 86°W 16.1 FT 3 1/2" MAG Nail Right
Side Center

Sketch of Monument, Accessories, and General Area

Location & Comments


MON on Westerly Edge of
Small Bench on Ridge BURNED
Old Growth South Reprod N.E.

AREA BURNED
9-2020

OCRS COORDINATE SYSTEM
Cottage Grove - Canyonville
Zone

Comp. Decline. 14 1/2° E
Agency DCSO
Party Chief S. FRAUSE
Note keeper
Witnesses J. LORSUNG

N 191597.442
E 267779.132

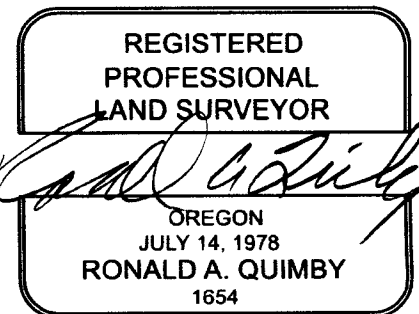

EXPIRES: 12/31/2024

CS 67/58-55 213

TOWNSHIP 25 RANGE 02 POINT IDENTIFIER # 340200

PRIMARY CORNER DESCRIPTION 1/4 Cor. Secs. 28 & 33 AUG 21, 2024

Alias _____	Description _____
Alias _____	Description <u>OGRS CANYONVILLE COTTAGE GROVE COORDS</u>
Alias _____	Description _____
Alias _____	Description <u>191597.442 N</u>
<u>DECLINATION 14 1/4° E</u>	
<u>267779.132 E</u>	

GLO Survey by Hezekiah H. Johnson, under Contract #721, dated May 1, 1900 (DCSO records Vol. 9 Page(s) 3627)

Set basalt stone 16x12x4", 11" in the ground for 1/4 sec. cor. marked 1/4 on N face, from which

A cedar, 36" dia., bears N.35°W., 80 lks., mkd: 1/4 S28 BT.
A chinquapin, 4" dia. bears S.69°W., 29 lks. mkd: 1/4 S33 BT

BLM dependent resurvey by Floyd A. Brooks, Cadastral Surveyor, under Group #350, surveyed April 1962 -(DCSO records Vol. 32 Page(s) 13230)

The 1/4 sec. cor. of secs. 28 & 33, monumented with a basalt stone, 16x12x4" firmly set 11" in the ground, marked 1/4 on the N face, from which the only remaining original bearing tree:

A cedar, 60" dia., bears N.35°W., 80 lks., with no marks remaining on burned-out blaze.

At the corner point

Set an iron post, 28" long, 2 1/2" dia., 22" in the ground, with brass cap marked

S 28
1/4
S 33
T25S R2W
1962

from which new bearing trees

A fir, 21" dia., bears N.40 1/2°W., 50 lks., 1/4 marked S28 BT.

A fir, 28" dia., bears S.25°E., 7 1/2 lks., 1/4 marked S33 BT.

Deposit the original corner stone alongside the iron post.

BLM Dependent resurvey by Richard J. Dieckmann, Cadastral Surveyor, under Group No. 2749, surveyed Aug. 2014/April 2015 - (DCSO records Vol. 58 Page(s) 23339-40)

The 1/4 sec. cor. of secs. 28 and 33, monumented with an iron post, 2 1/2" dia., firmly set, projecting 2" above the ground, in a collar of stone, with a brass cap (properly) mkd.

from which the remains of an original bearing tree

NOT SEEN - A decayed cedar stump, 42" dia., bears N.35°W., 52.8 ft., with no marks visible.

and remains of bearing trees mkd. by Brooks in 1962

BURNED DEAD 42" A D.V. Fir, 42" dia., bears S.25°E., 5.0 ft., with a healed **FALSE** blaze.

VERY ROTTED AND BURNED 25" X 3 1/2 FT A fir stump, 34" dia., bears N.40 1/2°W., 33.0 ft. with no marks visible on an open, decayed blaze **BLAZE GONE**

and a new bearing tree

BURNED DEAD 7" A D. Fir, 5" dia., bears N.21 1/2°E., 31 1/2 ft., mkd. ~~X~~ in the bark at breast height and BT in low blaze. **THIS BLAZE BURNED**

FOUND STEEL FENCE POST EAST, 19 FT.

HEALED LOWER BLAZE CS 67/58-2
3/3

NEW REF.

BURNED DEAD 43" SCHOOL MARM D. FIR 3 1/2" MAG NAIL RSC S86°W 16 FT

MON. ON WESTERLY EDGE OF SMALL BENCH ON RIDGE, BURNED OLD GROWTH! SOUTH REPROD NE

MINI 617
43.35838
122.94335