

GOVERNMENT CORNER RESTORATION FORM

FILED

TOWNSHIP 24S RANGE 1W SEC. 29

PLSS # 200200

Date: 10/2/2024 By: J

This survey consists of:

Map: _____

Narrative: _____

Corner Rpt: CS67/59-3

DOUGLAS COUNTY OREGON

DATE 9-19-24

DOUGLAS COUNTY SURVEYOR

Corner Designation

SEC COR 29-30-31-32

Monument(s) Found: (Condition and Source)

DCSO 2 1/2" BRASS CAP
ON 1" I.D. IRON PIPE
PROJ 12"

Previous Renewals

DCSO 1960 CS 52/42-2
DCSO 1970 CS 54/27-191
DCSO 1983 CS 62/7-5

Condition report

Not Found

Renewed

Unrecorded

Surveyed In

MONUMENT DETAIL

Douglas County
SURVEYOR OFFICE

T24S R1W

530/529

531/532

1960

Accessories Found

6" Rotted Fir stub N83°W 19.8 FT
16" D. Fir N29°E 53.0 FT Fully Healed
Double BLAZE ADD 3 1/2" MAG NAIL RSC
Rotted Broken 15" x 4" Fir stub S81°W
22.3 FT BLAZE Rotted AWAY
18" D Fir S22°W 42.0 FT Fully Healed
Double BLAZE ADD 3 1/2" MAG NAIL RSC
16" D. Fir N83°E 57.2 FT Fully Healed
Double BLAZE ADD 3 1/2" MAG NAIL RSC
Spike AND TAG IN 18" Rotted AND
BROKEN Fir STUMP N86°W 19.1 FT

C.S. File 62/59-3

New Accessories

Sketch of Monument, Accessories, and General Area

Location & Comments


CORNER LIES ON STEEP NW 2/4
SLOPE APPROX 200' EASTERLY
OF THE END OF BLM ROAD
#25-1-5.4 CORNER LIES IN
CUTTING LINE OLDER REPROD
N.W. OR CORNER

AREA BURNT
9/2020

O&RS COORDINATE REFERENCE
SYSTEM
COTTAGE GROVE - CANYONVILLE
ZONE

Comp. Decline. 14 1/2° E
Agency DCSO
Party Chief S. F. AUSE
Note keeper
Witnesses J. LORSUNG

N 225989.007
E 295075.202

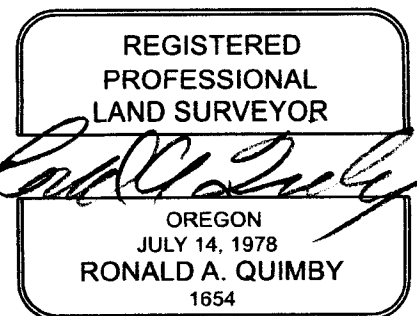

EXPIRES: 12/31/2024

CS 62/59-3

9/17/24

PRIMARY CORNER DESCRIPTION Cor. Secs. 29, 30, 31, & 32

Alias _____	Description _____
Alias _____	Description _____
Alias _____	Description _____
Alias _____	Description _____

1960 2 1/2" BC / 1" I.D. IRON PIPE MARKED AS DESCRIBED PROT-12"

ROTTED AWAY NO GOOD EVID. - Orig. 8" fir, now 8' dia., 4 ft. high stump bears S. 17°W., 8.5 ft. (rec. S. 26°W., 8.6 ft.) scribing legible (24 S R1W S31 BT)

6" STUB ROTTED - Orig. 8" fir now 2 stumps are close to bearing & dist. (rec. N. 83°W, 19.8 ft.)

LIVE 10" FIR 16" DIA - 12" fir now 12" fir, bears N. 29°E, 53.0 ft. Double blaze nearly healed. 1960 FHDB

ROTTED BROKEN 15" x 4" STUB - 18" Fir now 15" dia., snag, 15 ft. high, bears S. 81°W, 22.3 ft. Partially healed blaze, scribing visible. BLAZE ROTTED AWAY NO SCRIB. 8" fir destroyed.

NEW LIVE 16" STUB - fir, double blazed & scribed "T24S R1W S29 CS BT" FHDB bears N. 83°E., 57.2 ft.

LIVE 18" D. FIR 14" - Fir double blazed & scribed "T24S R1W S31 CS BT" FHDB bears S. 22°W., 42.0 ft.

STUMP ROTTED AND BROKEN BUT NAIL AND TAG GOOD - Set a 8"x1/2" spike in a 18" fir stump, bears N. 86°W., 19.1 ft. Spike set through a "DOUGLAS CO SURVEYORS OFFICE" BT tag in center of stump (stump is possible orig. 8" fir BT)

Note - Cor. lies on steep NW'y slope approx. 200 ft. easterly of the end of BLM rd. #25-1-5.4. Cor. lies in cutting lines. Clear cut NW of corner.

NOW OLDER REPROD.

OCS CANYONVILLE COTTAGE GROVE COORD.S

225989.007 N

295075.202 E

CS 67/59-3