

GOVERNMENT CORNER RESTORATION FORM

TOWNSHIP 255 RANGE 3W SEC. 7 PLSS # 140500

FILED

Date: 10/2/2024 By: LC  
This survey consists of:

DOUGLAS COUNTY OREGON

DATE 9-30-24

Map: \_\_\_\_\_

Narrative: \_\_\_\_\_

Corner Rpt: CS 67/59-7

Corner Designation

1/4 57  
1/4 518

DOUGLAS COUNTY  
SURVEYOR

Monument(s) Found: (Condition and Source)

Condition report

Not Found

Renewed

Unrecorded

Surveyed In

1944 GLO BRASS CAP  
proj 18" Bent straightened  
ADD Rough stone mound

Previous Renewals

GLO 1883 Vol 9 pg 3723-24  
GLO Resurvey 1940 Vol 27 pg 11600  
DCSO 1966 CS 54/27-23  
Hoffine 2011 M 162-21

MONUMENT DETAIL

1/4 57  
1/4 518  
1944

Accessories Found

Singed base 19" D. Fir N 83°W 35.6 FT  
(Rec N 79 1/2° W) Fully Healed single BLAZE  
ADD 3 1/2" MAG NAIL RIGHT SIDE CENTER

Burned BASE 32" D. Fir S 59°E 20.0 FT  
(Rec S 58°E 20.3 FT) Fully Healed single  
BLAZE Add 3 1/2" MAG NAIL RIGHT SIDE  
CENTER

C.S. File 67/59-7

1/3

New Accessories

BURNED SAWN 13" X 1 1/2 FT D. FIR STUMP  
S32 1/2° E 22.0 FT 3 1/2" MAG NAIL TOP  
CENTER

BURNED DEAD 10" D. FIR WITH LINE BLAZE  
FOR E-W-LINE N46°W 8.6 FT 3 1/2"  
MAG NAIL RIGHT SIDE CENTER

Sketch of Monument, Accessories, and General Area

Location & Comments

MON IS ON EAST-WEST CUTTING  
LINE OLD GROWTH NORTH CLEAR  
CUT TO SOUTH


AREA BURNT  
9/2020

OGRS COORDINATE SYSTEM  
COTTAGE GROVE - CANYONVILLE  
ZONE

Comp. Decline. 14 1/4° E  
Agency DCSO  
Party Chief S. F. LAUSE  
Note keeper  
Witnesses J. LORSON

N 208598.948

E 226363.347

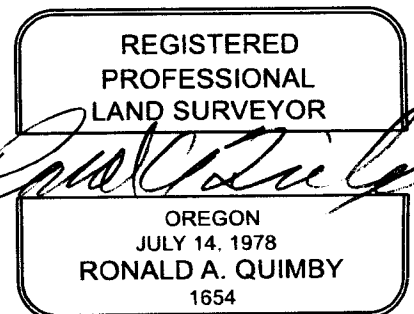

EXPIRES: 12/31/2024

CS 67/59-7  
2/3

TOWNSHIP 25 RANGE 03 POINT IDENTIFIER # 140500

PRIMARY CORNER DESCRIPTION 1/4 Cor for Secs 7 and 18

Alias	Description
Alias	Description
Alias	Description
Alias	Description

New BTs - 5" D. Fir N.80°W., 35.7 ft. mkd. 1/4 S7 CS BT.  
 14" D. Fir S.60°E., 21.0 ft. mkd. 1/4 S18 CS BT.  
 Corner lies on fairly steep SW slope approx. 100 ft. N.75°E.  
 of old unused logging road, course NE-SW.

Ken Hoffine - For: Lone Rock Timber Co. - 3/2011 - M162-21

Found - 1944 GLOVcap 18" above ground and leaning slightly in a westerly direction. *LEANS 570°W 0.7 FT WE STRAIGHTEN ADD ROUGH MOUND OF STONE AROUND BASE*  
 SINGED BASE LINE 19" D. Fir 18" D. Fir bears N.79°W., 35.6 ft. (record N.80°W 35.7 ft) healed face and tag. *N 83°W 35E FHSB*  
 BURNED BASE LINE 32" D. Fir 29" D. Fir bears S.58°E., 20.3 ft (record S.60°E., 21.0 ft) healed face and tag. *S 59°E 20.0 FHSB*

Corner lies on west facing slope approx. 110 feet northeast along section line from an old skid road.

*ADD 3 1/2" MAG NAIL R.S.C. TO ALL FOUND AND THE ONE NEW BEARING TREE*

NEW REF.S

13" x 1/2" TALL BURNED SAWN D. FIR STUMP 3 1/2" MAG NAIL TOP CNTR S 32 1/2° E, 22° FT.

BURNED DEAD 10" D. FIR HAS LINE BLAZES FOR E-W LINE: N 46° W, 89 FT.  
 MONUMENT IS ON EASTERLY-WESTERLY CUTTING LINE; OLD GROWTH TO NORTH  
 CLEAR CUT TO SOUTH

OARS CANYONVILLE COTTAGE GROVE COORDS

208598.948 N  
 226363.347 E