

GOVERNMENT CORNER RESTORATION FORM

TOWNSHIP 24S RANGE 3W SEC. 11

PLSS # 600500

FILED  
Date: 10/28/2024 By: X

This survey consists of:

Map: \_\_\_\_\_

DOUGLAS COUNTY OREGON

DATE 10-17-24

Narrative: \_\_\_\_\_

Corner Rpt: CS67/59-9

Corner Designation

SEC COR S11/S12  
S14/S13

DOUGLAS COUNTY  
SURVEYOR

Monument(s) Found: (Condition and Source)

BRASS CAP ON 2"  
IRON PIPE UP 2"

\_\_\_ Condition report

\_\_\_ Not Found

Renewed

\_\_\_ Unrecorded

\_\_\_ Surveyed In

Previous Renewals

Hale 1954 CS 53/111-17  
Baker 1983 M90-48

MONUMENT DETAIL

Accessories Found

FIR STUMP 58" X 4 FT S 48° E 68.5 FT  
(REC N 50° E 46.5 FT TO FACE) ADD 3 1/2" MAG  
NAI) TOP CENTER

Root Hole S 50 1/2° W 48.2 FT

Root Hole S 17° E 13.9 FT

---



---



New Accessories

SAWN FIR STUMP 19" X 1 1/2' FT N 69° E  
9.4 FT 3 1/2" MAG NAIL TOP CENTER

SAWN FIR STUMP 22" X 2 FT S 35° W  
18.0 FT 3 1/2" MAG NAIL TOP CENTER

Sketch of Monument, Accessories, and General Area


Location & Comments

OCS COORDINATE SYSTEM  
COTTAGE GROVE - CANYONVILLE  
ZONE

AREA BURNT  
9-2020

N 239630.754  
E 249566.359

Comp. Decline. 14' 14" E  
Agency DCSO  
Party Chief S. F. RAUSE  
Note keeper  
Witnesses J. LOBSUNY

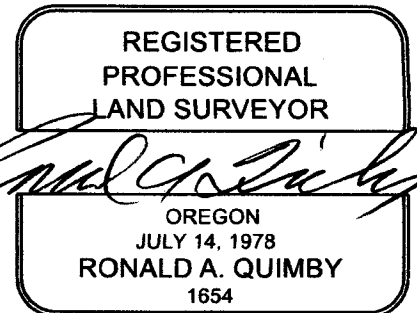

EXPIRES: 12/31/2024

CS 67/59-9

