

GOVERNMENT CORNER RESTORATION FORM

FILED

TOWNSHIP 26S RANGE 1W SEC. 7

PLSS # 100570

Date: 12/2/2024 By: X

This survey consists of:

Map: _____

DOUGLAS COUNTY OREGON

DATE 11-4-24

Narrative: _____

Corner Rpt: CS67/59-11

Corner Designation

N-N 1/4

DOUGLAS COUNTY SURVEYOR

Monument(s) Found: (Condition and Source)

___ Condition report

3" BRASS CAP ON 2 1/4"

___ Not Found

I.D. IRON PIPE PROJ 8"

Renewed

___ Unrecorded

Previous Renewals

___ Surveyed In

Established By GARRETT
1972 Per M 47-7

MONUMENT DETAIL

T26S R1W

N-N 1/4

S7

1972

RPLS 544

Accessories Found

BURNED - DEAD 16" MADRONE SURROUNDED
BY NUMEROUS SMALL ROOT SPROUTS

N112°E 14.1 FT SCRIBE VISIBLE ON
PARTIALLY HEALED BLAZE NN 1/4 ADD
3 1/2" MAG NAIL RIGHT SIDE CENTER

Root Hole S24°E 14.9 FT

Steel Fence Post with SIGNS PROPERTY
LINE & SURVEY MONUMENT EAST 4.9 FT

RENEWAL

Monument Set (Procedure and Description)

MONUMENT DETAIL

New Accessories

Sketch of Monument, Accessories, and General Area

Location & Comments

MON ON Gentle South
Slope old Growth Forest
IN N.E QUADRANT REST
Burnt Reprod ± 15K Trees


MON IS APPROX
250' EAST OF
GRAVEL ROAD

AREA BURNED
9/2020

OCS COORDINATE SYSTEM
COTTAGE GROVE - CAMPOVILLE
ZONE

Comp. Decline. 14'14"E
Agency DCSO
Party Chief S. F. LAUSE
Note keeper
Witnesses J. JORSUMB

N 179901.402
E 286213.220

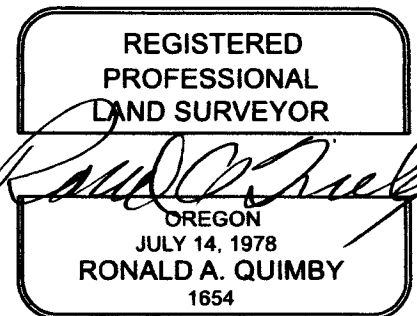

EXPIRES: 12/31/2024

CS 67/59-11
2/3

EGON
GARRETT
544

NO. 1
(Rec.)

8" Fir Bears N6°E 19.8' Scribed CW 1/6 S7 BT
Set Brass Cap Marked T26S, R1W, CN NW 1/64, S7, 1972, RPLS 544
6" Fir Bears S16°W 8.1' Scribed CN NW 1/64 S7 BT
9" Fir Bears N71 1/2°W 18.7' Scribed CN NW 1/64 S7 BT

Set Brass Cap Marked T26S, S6, S7, R1W, T26S, R2W, S12, 1972, RPLS 544
13" Fir Bears N6°E 10.1' Scribed T26S R1W S6 BT
11" Fir Bears S48 1/2°E 32.8' Scribed T26S R1W S7 BT

Found Brass Cap Marked County Surveyors Office T26S, R2W, S1, S12, 1961
13" Fir Bears N30°W 21.5' (Shows Scar)
12" Cedar Bears S86°W 8.4' (Shows Scribe)

CC S6, S7, T26S, R1W Found Broken Basalt Stone, 16" X 12" X 6", Set Approx. 12" In Ground. 1/2" I. Pipe in Place on East Side of Stone.
9" Madrone Bears S25°E 28 Lks. Tree has been opened. No Scribing found. See 1968 Cadastral Resurvey of the East Line of Sect 12, T26S, R2W.

3" BRASS CAP ON 2 1/4" I.P. PROT. 8 INCHES
Set Brass Cap Marked T26S, R1W, N-N 1/64, S7, 1972, RPLS 544
Madroney Bears N12°E 14.1' Scribed NN 1/64 S7 BT NOW BURNED PHB NN 1/64 VISIBL
Scribed ~~NN 1/64~~ BT ADD 3 1/2" MAG-MAIL R.S.C.
Chinquapin Bears S2°E 14.9' ~~Scribed NN 1/64~~ ROOTHOLE

Found Brass Cap Marked County Surveyors Office, T26S, R2W, 1/4 S12, 1961
16" Cedar Bears N80°W 18.0'
21" Fir Bears S43°W 61.2'

Found Brass Cap Marked County Surveyors Office, T26S, R1W, 1/4 S7, 1961
22" Chinquapin Bears N28°E 48.2' (Shows Scribe)
8" Cedar Bears S87 3/4°E 39.3'

CCAS CAMDENVILLE COTTAGE GROVE COORDS
179901.402 N
286213.220 E

RENEWED 11/4/24
DECLINATION 14 1/4° EAST

NOW LIGHTLY BURNED BUT DEAD 16" TREE SURROUNDED BY NUMEROUS SMALL ROOT SPROUT STEMS
BURNED BELOW GROUND

NEW REFERENCE:
FIND A STEEL FENCE POST WITH ATTACHED PROPERTY LINE AND SURVEY MONUMENT SIGNS BEARING EAST 49 FEET DISTANT.

MONUMENT ON VERY GENTLE SOUTH SLOPE
BURNED OLD GROWTH FOREST IN NE QUADRANT
REST BURNED UP YOUNG REPROD (~15 FT TREES)

MONUMENT IS APPROX. 250 FT. EASTERLY FROM GRAVEL RD.

M 47-7

CS 67/59-11
313