

GOVERNMENT CORNER RESTORATION FORM

TOWNSHIP 26S RANGE 1W SEC. 7

PLSS # 200500

FILED
Date: 12/2/2024 By: XC
This survey consists of:

DOUGLAS COUNTY OREGON

DATE 11-5-24

Map: _____
Narrative: _____
Corner Rpt: CS 67/59-R

Corner Designation

SEC COR 7/8
18/17

DOUGLAS COUNTY
SURVEYOR

Monument(s) Found: (Condition and Source)

BRASS CAP BURIED ± 2 FT
below ROAD SURFACE 7 FT
SOUTH OF ROAD &

- Condition report
- Not Found
- Renewed
- Unrecorded
- Surveyed In

Previous Renewals

DCSO 1963 CS 57/77-11 Not FD
GARRETT 1972 M 47-7
GRAY LORN 1979 CS 60/24-20
STANLEY 2007 ST HWY 138-011F

MONUMENT DETAIL

Accessories Found

Burnt-Dead 22" D. FIR 555°E 78.4 FT Healed
Double BLAZE
SAWN BURN 32" X 3 FT FIR STUMP 546°W 53.2 FT
(REC 52.5 FT) Healed Lower BLAZE
2 1/2" BRASS CAP W.C. BEARS North 50.0 FT
AT TOP OF CUT BANK
BT'S TO WITNESS COR
SAWN BURN 34" X 2 FT W. FIR STUMP N 73°30'E
61.9 FT EVIDENCE OF BLAZE INSIDE ADD
3 1/2" MAG NAIL Top Center
SAWN BURN 32" X 2 FT D. FIR STUMP N 35°W 30.8 FT
EVIDENCE OF BLAZE INSIDE ADD 3 1/2" MAG NAIL
Top Center

SAWN BURN

New Accessories

New Ref. measured from True Corner
A 5/8" x 30" Iron Rod with DCSO
Plastic Cap 556°E 26.0 FT Proj. 1"

Sketch of Monument, Accessories, and General Area

Location & Comments

OCRS COORDINATE System
Cottage Grove - Canyonville
Zone

N 175502.538

E 291567.279

True Corner is in
S. Edge of F.S. Rd
#2604

AREA BURNT
9/2020

Comp. Decline. 14 1/4° E


Agency DCSO

Party Chief S. F. AUSE

Note keeper

Witnesses J. LORSON

CS 67159-12
214

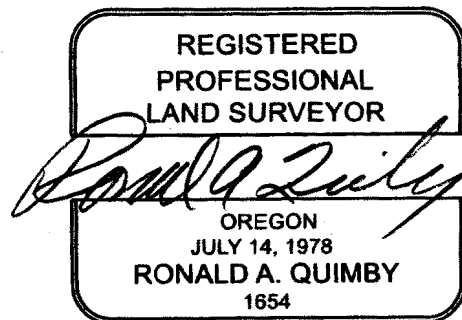

EXPIRES: 12/31/2024

TOWNSHIP 26 RANGE 01 POINT IDENTIFIER # 200500

PRIMARY CORNER DESCRIPTION Cor. Secs. 7, 8, 17, & 18

Alias _____	Description _____
Alias _____	Description <u>CCRS CANYONVILLE COTTAGE GROVE LEONARD S</u>
Alias _____	Description _____
Alias _____	Description <u>175502.538 N</u>
	<u>291567.279 E</u>

GLO survey by Fred Mensch, Deputy Surveyor - contract #797 dated April 19, 1910 - (DCSO records Vol. 10 Page(s) 4161)

Set a conglomerate stone 18x8x6", 12" in the ground for cor. of secs. 7, 8, 17, & 18 mkd with 4 notches on S & 5 notches on E edge, from which

An Alder, 8" dia., bears N.21°E., 33 lks., mkd: T26S R1W S8 BT.

An Alder, 7" dia., bears S.70°E., 13 lks., mkd: T26S R1W S17 BT.

A fir, 40" dia. bears S.31°W. 14 lks. mkd: T26S R1W S18 BT

An Alder, 7" dia., bears N.53°W., 22 lks., mkd: T26S R1W S7 BT.

Douglas Co. Surveyors Office - Milo Godfrey - 3/1963 - C.S. File 52/77-11

Not found.

Fd. yellow tag only indicating cor.

On N edge old N.Umpqua Rd. just East of burnt Ck.

No BTs or cor rock fd.

Don Garrett - For: United States of America - 10/1972 - M47-7

Set - Brass cap, 6" below road surface, mkd: T26S R1W S7, S8, S17, S18, RPLS 544

15" Fir bears S.66°W., 52.5' scribed T26S R1W S18 BT

9" Fir bears N.32°W., 36.7' scribed T26S R1W S7 BT

18" Fir bears N.27°E., 21.0' scribed T26S R1W S8 BT

8" Fir bears S.55½°E., 78.4' scribed T26S R1W S17 BT

DECLINATION 14¼°E *RENEWED 11/15/24*

Dennis Gaylord, USFS & Deputy Co. Surveyor - Witness: Tony Flores - March 15, 1979 - C.S. File 60/24-20

Found - A 2½" Brass cap buried ~~5~~ *2 FT* under the road surface, stamped T26S R1W S7 S8 S18 S17 1972 RPLS 544-1972

NO EVID. Possible orig. BT, a 42" D. Fir bears N.39°W., 44.4 ft. Has a single healed blaze. I open this tree but find no scribing. No sign of orig. corner stone. I discount this tree as being an orig. Mensch BT.

NO EVID. A 13" W. Fir bears N.31°30'W., 36.7 ft. Some scribing visible on a nearly healed double blaze.

NO EVID. A 20" D. Fir bears N.29°30'E., 20.3 ft. has healed double blazes.

BURNED NEAR 22" A 12" D. Fir bears S.55°E., 78.4 ft. has double healed blazes. ✓

continued next page

OVER →

CS 67/59-12 3/4

TOWNSHIP 26 RANGE 01 POINT IDENTIFIER # 200500

PRIMARY CORNER DESCRIPTION Cor. Secs. 7, 8, 17, & 18.

Alias _____	Description _____
Alias _____	Description _____
Alias _____	Description _____
Alias _____	Description _____

SAWN BURNED 32" x 3 FT STUMP A 17" D. Fir bears S. 66° W. ^{53.2} 52.5 ft to base of tree at HEALED LOWER BLZ center (tree is leaning) has double healed blazes.

Set - A 2 1/2" Brass cap on a 1" x 36" I.P. as a witness PROT. 10" - corner. This W.C. monument bears North, 50.0 ft. from the true corner monument and is marked from the true corner monument and is marked County Surveyor's Office T26S R1W W C S7 S8 S18 S17 South 50.0 1979.

New - (these BTs are referenced to the witness cor. monument)

SAWN BURNED 34" x 2 FT STUMP A 20" W. Fir bears N. 73° 30' E., 61.9 ft. scribed "T26S R1W S8 WC CS BT" on a double blazes. ADD 3 1/2" MAG NAIL TOP CENTER BOTH STUMPS

" " 32" x 2 1/2 FT. " A 21" D. Fir bears N. 35° W., 30.8 ft. scribed "T26S R1W S7 WC CS BT" on double blazes. EVIDENCE OF BLZ. INSIDE

TRUE - Corner lies in left edge of P.S. Road #2604 SOUTH

James M. Stanley, ODOT - Sept/Nov. 2007 - St. Hwy 138-011F

Fd. 2 1/2" brass cap stamped "COUNTY SURVEYORS OFFICE T26S R1W S7 S8 S18 S17 WC SOUTH 50.0 1979" (10-16-07)

NEW REF. MEAS. FROM 7/8 MON. 18/17

5/8" x 30" I.R. / PCSG PLASTIC CAP SET PROT 1" BEARS S 56° E, 26° FT.

CS 67/59-12 2
414