

GOVERNMENT CORNER RESTORATION FORM

FILED

TOWNSHIP 24S RANGE 3W SEC. 13

PLSS # 600440

Date: 12/2/2024 By: X  
This survey consists of:

DOUGLAS COUNTY OREGON

DATE 11-19-24

Map: \_\_\_\_\_

Narrative: \_\_\_\_\_

Corner Rpt: CS 67/59-13

Corner Designation

1/4 COR S14/S13

DOUGLAS COUNTY  
SURVEYOR

Monument(s) Found: (Condition and Source)

2 1/2" BRASS CAP  
projecting 8"

\_\_\_ Condition report

\_\_\_ Not Found

Renewed

\_\_\_ Unrecorded

\_\_\_ Surveyed In

Previous Renewals

Juliano 1973 CS 55/316  
Schinnell 2006 M150-51

MONUMENT DETAIL

Accessories Found

Burnt - SAWN 22" X 5 FT CEDAR STUMP S 40 E  
13.18 FT (REC SOUTH) TO FOUND NAIL IN FACE  
PARTLY HEALED BLAZE FACE BURNT

Burnt - SAWN 14" X 1 FT FIR STUMP N 57 W  
9.0 FT (REC 9.3 FT) HEALED BLAZE ADD  
3 1/2" MAG NAIL TOP CENTER

Burnt - SAWN 15" X 3 1/2 FT HEMLOCK STUMP  
N 81 E 17.14 FT TO FOUND NAIL IN FACE  
PARTLY HEALED SINGLE BLAZE FACE BURNT

C.S. File 67/59-13

RENEWAL

Monument Set (Procedure and Description)

MONUMENT DETAIL

New Accessories

Burnt-SAWN 14" X 1 FT Fire Stump N29W  
14.7 FT 3 1/2" MAG NAIL TO CENTER

Sketch of Monument, Accessories, and General Area

Location & Comments


MON. IN bottom of shallow draw  
19 FT West of Northly Flowing  
Creek. 40 FT West of N-S cutting  
line Burned old Growth EAST  
Large Clearcut west

MON IS APPROX 500  
FT. EAST OF GRAVEL  
ROAD

OCRS Coordinate System  
Cottage Grove - Canyonville  
Zone

Comp. Decline. 14 1/4° E  
Agency DCSO  
Party Chief S. FIAUSE  
Note keeper  
Witnesses J. LORSUNG

N. 173143.714  
E 249921.829

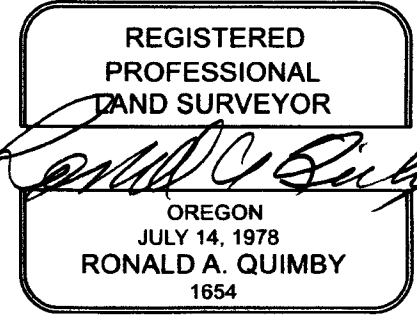

EXPIRES: 12/31/2024

CS 67/59-13  
213

TOWNSHIP 26 RANGE 03 POINT IDENTIFIER # 600440

PRIMARY CORNER DESCRIPTION 1/4 Cor. for Secs. 13 and 14

Alias \_\_\_\_\_ Description \_\_\_\_\_  
 Alias \_\_\_\_\_ Description CCRS CANYONVILLE COTTAGE GROVE CORO.S  
 Alias \_\_\_\_\_ Description \_\_\_\_\_  
 Alias \_\_\_\_\_ Description 173143.716 N  
249921.829 E

Original - Samuel C. Flint, Under Contract #454, dated June 19, 1882 (DCSO records, Vol. 10 Page 4391)

-----  
 Set Cedar post, 3 ft. long, 3" sq., for 1/4 sec. cor. marked on E and W faces, 1/4 S., from which  
 A Hemlock 12" dia., bears N.45°E., 28 lks. dist., marked 1/4 S BT.  
 A Hemlock 12" dia., bears S.40°W., 37 lks. dist., marked 1/4 S BT.

Nick Juliano, for Weyerhaeuser Company - Sept. 1973  
C.S. File 55/316

-----  
 Corner set by proportionate measurement.  
 Set 2 1/2" Iron pipe with brass cap.  
 BTs - 22" hemlock N.69°W., 23.9 ft. to RR spike.  
 38" hemlock S.13°E., 46.1 ft. to RR spike.

DECLINATION 14 1/4° E

RENEWED 11/19/24

Kevin Schinnell - For: Rosboro Lumber Co. - 5/2006 - M150-51

-----  
 Found - 2 1/2" brass monument on 2 1/4" iron pipe & one accessory as follows:

POSSIBLE ADJUSTS  
 GONE - 36" hemlock S.15°E., 46.10' (W.T.Co. Tag)  
 BURNED SAWN 22" NEW x 5 STUMP 20" cedar south 13.18' 50 4° E TO FOUND NAIL IN FACE PHS  
 BURNED SAWN 14" x 1" STUMP 12" fir N.57°W, 9.30' 90' ADD 3 1/2" MAG NAIL TO CENTER, WELD BIZ SCAP  
 BURNED SAWN 15" x 3 1/2" STUMP 4" hemlock N.81°E., 17.44' TO FOUND NAIL IN FACE PHS  
 Note - All accessories repainted and flagged at this time

NO SCRB FACE BURNED  
WELD BIZ SCAP  
NO SCRB FACE BURNED

NEW REF. BURNED SAWN 14" x 1" FIR STUMP 3 1/2" MAG NAIL N29°W, 14' TOP CNTR.

MONUMENT IN BOTTOM OF SHALLOW DRAW 19 FT WEST FROM NTHLY RUNNING CREEK AND 40 FT WEST FRO N-S CUTTING LINE BURNED OLD GROWTH EAST, LARGE BURNED CLEARCUT WEST MONUMENT IS APPROX. 500 FT. EAST FRO A GRAVEL RD.

CS 67/59-13  
313

PM 2-69  
540.600  
1

MINI GIS  
4380790  
123.01070

PLAIN BRASS CAP PROPERLY MARKED - PROT. 8"