

GOVERNMENT CORNER RESTORATION FORM

FILED

TOWNSHIP 215 RANGE 8W SEC. 25

PLSS # 640206

Date: 12/2/2024 By: JK
This survey consists of:

DOUGLAS COUNTY OREGON

DATE 11-21-24

Map: _____

Narrative: _____

Corner Rpt: CS 67/59-14

Corner Designation

1/4 COR 25
36

DOUGLAS COUNTY
SURVEYOR

Monument(s) Found: (Condition and Source)

DCSO BRASS CAP
FLUSH WITH GROUND

___ Condition report

___ Not Found

Renewed

___ Unrecorded

___ Surveyed In

Previous Renewals

BLM RESURVEY 8-1952 TO
10-1954 Vol 30 pg 12558
DCSO 1968 CS 54/67
BLM RESURVEY 2007
Vol 56 pg 22054-5

MONUMENT DETAIL

COUNTY SURVEYORS
OFFICE
T215 R8W

1/4 525
536
1968

Accessories Found

10" x 8 FT Rotted Alder SNAQ N 20³14° E
19.3 FT

14" Alder S 11¹2° W 9.3 FT WITH
ILLEGIBLE BARK SCRIBES

C.S. File 67/59-14

RENEWAL

Monument Set (Procedure and Description)

MONUMENT DETAIL

New Accessories

A 14" Alder N 20° E 8.7 FT BARK
scribed 1/4 525 BT


Sketch of Monument, Accessories, and General Area

Location & Comments

OCRS Coordinate System
Cottage Grove - Canyonville
Zone

N 318758.765
E 95188.412

Comp. Decline. 14 1/4° E
Agency DCSO
Party Chief S. F. Aulse
Note keeper
Witnesses J. Loring

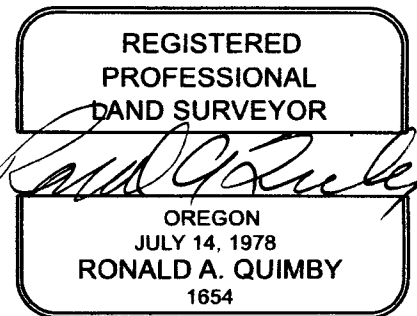

EXPIRES: 12/31/2024

CS 67/59-14

2/4

TOWNSHIP 21 RANGE 08 POINT IDENTIFIER # 640200

PRIMARY CORNER DESCRIPTION 1/4 Cor. Secs 25 & 36

Alias _____	Description _____
Alias _____	Description _____
Alias _____	Description _____
Alias _____	Description _____

GLO survey by Wm. P. Wright, Deputy Surveyor, under contract #486, dated Aug. 1, 1883 - (DCSO recs. Vol. 2 Page(s) 839)

Maple, 20" dia. for 1/4 sec. cor. mkd 1/4 S on N face from which:
Maple, 18" dia., bears N.25°E., 10 lks., mkd: 1/4 S BT.
Chinquapin, 12" dia., bears S.12°W., 47 lks., mkd: 1/4 S BT.

BLM dependent resurvey by Marvin J Lytle, Palmer Norseth, Thomas A Tillman, Raymond M Bicknell, Joseph S Gawron & Hans W Thielsen, Cadastral Engineers, under Group #304, Surveyed Aug. 1952 thru Oct. 1954 - (DCSO recs. Vol. 30 Pg 12558)

Point for 1/4 sec. cor. of secs. 25 & 36, at proportionate distance; there is no remaining evidence of the orig. corner. Set an iron post, 12" long, 1" dia., 10" in drill hole in sandstone bedrock swelled into hole by a metal wedge in the split lower end, with brass cap marked:

1/4	S 25
	S 36
	1952

from which

A W.Fir, 35" dia., bears S.64°E., 74 lks., mkd: 1/4 S36 BT.
A Fir, 57" dia., bears N.66°W., 52 lks., mkd: 1/4 S25 BT.

Douglas Co. Surveyors Office - Vernon "Ray" Tracy - Jack Heritage - V. Perron - April 1968 - C.S. File 54/67

Found - No trace of 1952 GLO brass cap, apparently destroyed by road construction.

35" W.Fir, now stump, S.64°E., 48.8 ft., scribe visible on burned blaze. Rescribed "1/4 S36 CS BT"

Set - Brass cap at cor. mkd: COUNTY SURVEYORS T21S R8W
OFFICE 1968 1/4 S 25
S 36

No trees close. Steel fence post with yellow line tag bears West 44.0 ft.

Corner lies on East side of road at foot of fill & west of edge of creek, course S.30°W.

Dependent resurvey by Edith M Forkner, Cadastral Surveyor, under Group #2115, surveyed January/May 2007 (DCSO records Vol. 56 Page(s) 22054-5)

The 1/4 sec. cor. of secs. 25 & 36, perpetuated by Douglas Deputy County Surveyor's Office, in 1968, monumented with an iron post, 1 1/2" dia., firmly set, projecting 30" above ground, in a mound of stone, 2 ft. base, 24" high, with brass cap (properly) mkd. continued next page

DUE TO SILTING B.C. MONUMENT (AS DESCRIBED) IS FLUSH WITH SURROUNDING GROUND.

CS 67/59-14

3/4

MINI GIS
43.70741
123.59371

TOWNSHIP 21 RANGE 08 POINT IDENTIFIER # 640200

PRIMARY CORNER DESCRIPTION 1/4 Cor. Secs 25 & 36

Alias _____	Description _____
Alias _____	Description <u>CCRS CANYONVILLE COTTAGE GROVE CORNERS</u>
Alias _____	Description _____
Alias _____	Description <u>318758.765 N</u>

DECLINATION 14 1/2° E 95188.412 E

RENEWED 11/21/24

SEE 1ST PAGE FOR MON.

from which the remains of a BT mkd by Lytle, et al in 1952-54
A decayed W. Fir stump, size indeterminate, bears S.64°E.
48.8 ft. no marks visible. NOT SEEN

and bearing trees mkd. by person(s) unknown

ROTTED SNAG
10" x 8 FT

— An alder 11" dia., bears N.20 3/4° E. ✓, 19.3 ✓ ft., no marks visible.

14" — An alder, 12" dia., bears S.11 1/2° W. ✓, 9.3 ✓ ft., with illegible scribe marks visible on bark ✓

Drive a red Carsonite post alongside the cor.

Corner is located at the bottom of the fill bank for Paradise Creek Road.

NEW REF

14" ALDER BARK SCRIBED 1/4 S25 BT BEARS N20°E, 97 FT.