

GOVERNMENT CORNER RESTORATION FORM

FILED

TOWNSHIP 26S RANGE 1W SEC. 6

PLSS # 100600

Date: 12/3/24 By: SC

This survey consists of:

Map: _____

DOUGLAS COUNTY OREGON

DATE 11-4-24

Narrative: _____
Corner Rpt: CS 67/59-15

Corner Designation

CC 512 | 56
57

DOUGLAS COUNTY
SURVEYOR

Monument(s) Found: (Condition and Source)

3" BRASS CAP PROJ
12" ABOVE GROUND

___ Condition report

___ Not Found

Renewed

___ Unrecorded

___ Surveyed In

Previous Renewals

GLD SURVEY 1913 Vol 10 pg 4245
BLM RE SURVEY 1968 Vol 34 pg 14270
GARRETT 1972 M 47-7
DCSO 1987 CS 62/40-16E.17

MONUMENT DETAIL

T26S
R2W 512 | 56
57 R1W

1972

RPLS 544

Accessories Found

BURNED - DEAD 24" X 24" Double Trunk
D. FIR N12°E 8.6 FT (REC N 6°E 10.1 FT)
ADD 3 1/2" MAG NAIL RIGHT SIDE CENTER
BURNED TO GROUND D. FIR S48 1/2°E 32.8 FT TO
REMAINS
Post & metal w. brass sign south 4.5 FT

THE ORIGINAL CLOSING CORNER MONUMENTED
WITH 7" X 12" X 2" STONE & 1/2" IRON PIPE
BEARS WEST 12.04 FT
FROM WHICH A BURNED-DEAD 8" MADRONE
S 25°E 18.9 FT BLAZE GONE
13" D. FIR BURNED TO GROUND S 59°E 42.5 FT
24" X 24" Double Trunk D. FIR N 55°E 16.3 FT
(REC 14.6 FT) ADD 3 1/2" MAG NAIL RIGHT
SIDE CENTER

C.S. File 67/59-15

New Accessories

BURNED DEAD 29" D. FIRE S 18° E 26.6 FT
with 3 1/2" MAG NAIL RIGHT SIDE CENTER

Sketch of Monument, Accessories, and General Area

Location & Comments

OCRS COORDINATE SYSTEM
Cottage Grove - Canyonville
zone


N 180723.882

E 286336.671

AREA BURNED

9/2020

Comp. Decline. 14'14" E
Agency DCSD
Party Chief S. Klause
Note keeper
Witnesses J. Lorusong

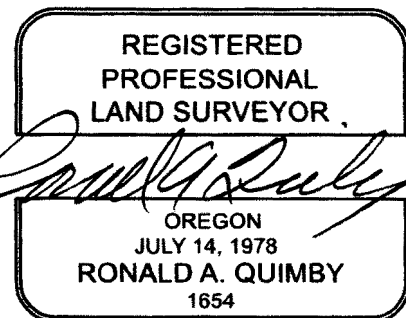

CS 67/59-15

214

TOWNSHIP 26 RANGE 02 POINT IDENTIFIER # 708574

PRIMARY CORNER DESCRIPTION C C for Secs. 6 & 7 only, T26-1

Alias _____	Description _____
Alias _____	Description _____
Alias _____	Description _____
Alias _____	Description _____

GLO survey by Fred Mensch, Deputy Surveyor, under Contract #797, dated April 19, 1910 - (DCSO records Vol. 10 Page(s) 4166)

Set a basalt stone 16x12x12 ins., 11" in the ground for closing cor. of secs. 6 and 7, marked CC on E. with 1 groove on N. and 5 grooves on S. face, from which

A Chinquapin 10" dia., bears N.72°E., 44 lks. dist. mkd. T26S R1W S6 BT.

A Madrone 6" dia., bears S.25°E., 28 lks. dist. mkd. T26S R1W S7 BT.

Fd. and tied in GLO survey by C.M. Collier, Deputy Surveyor, under Instructions dated May/Sept. 1913 - (DCSO records Vol. 10 Page(s) 4265)

Fd. OK in BLM Resurvey by Lynn M. Roseberry, Cadastral Surveyor, under Group #644, Surveyed April 1968 - (DCSO records Vol. 34 Page(s) 14270)

Don E. Garrett - For: United States of America - October 1972 M 47-7

Set Brass cap mkd. "T26S S6 S7 R1W T26S R2W S12 1972 RPLS 544", from which

13" Fir bears N.6°E., 10.1 ft. scribed T26S R1W S6 BT.

11" Fir bears S.48½°E., 32.8 ft. scribed T26S R1W S7 BT.

Douglas Co. Surveyors Office - Randall Smith and Stephen Flause, crew - April 19, 1987 - **C.S. file 62/40-16 & 17**

From the 1910 Mensch retracement: *DECLINATION 14¼°E* *RENEWED 11/4/24*
 Found - An orig. 16x12x12 ins. basalt stone, now measuring 7"x12"x2" high on portion protruding from ground. Because of severe frost cracking, we do not remove to examine further.

C.S. 62/40-17: From Garrett Survey M 47-7:
 Found - On the E. edge of above stone is a 1/2" I.D. Iron pipe protruding 3" above ground.
 (Bearings and distances measured from 1/2" Iron pipe)
 From 1910 retracement, a Madrone 6" dia. now a 9" DBH Madrone bears S.25°E., 18.9 ft. as per rec. No evidence found of scribing in previously opened blaze. *BLAZE GONE*

No evidence found of NE. Chinquapin BT.

We add new closing corner from Garrett Survey M 47-7, a 3" dia. brass cap on a 2" I.D. Iron pipe protruding 8" above
 (Cont. Next Page)

MINIGS
43.32823
122.87372

DEAD BURNED OUT 8" SNAG

TOWNSHIP 26 RANGE 1 POINT IDENTIFIER # 200574 100600

PRIMARY CORNER DESCRIPTION C C for Secs 6 & 7 only, T26-1

Alias _____	Description _____
Alias _____	Description <u>OARS CANYON LITTLE COTTAGE GROVE CORNER</u>
Alias _____	Description _____
Alias _____	Description <u>130723.882 N</u>
	<u>286336.671 E</u>

ground, bears East, 12.04 ft. dist. (as per M47-7) We also tie SE. BT, for the above mentioned cap:

BURNED TO GROUND
Originally an 11" Fir scribed T26S R1W S7 BT, now a 13" DBH D.Fir with a fully healed double blaze, bears S.59°E, 42.5ft.

BURNED DEAD NOW 24" X 24" DOUBLE TRUNK
A New BT, a 15" DBH D.Fir scribed CC T26S R1W S6 CS BT on a double blaze, bears N.55°E., ~~14.6~~ 16.3 ft. *TO 3 1/2" MAG NAIL RIGHT SIDE BASE*

Monument is at East edge of old clear cut on a still definite N-S cutting line and is S. approx. 350 ft. from a creek, coursing N.75°E.

AND

C.S. 62/40-16

(Closing corner for Secs. 6 & 7 only, T26-1 from Garrett survey M 47-7)

Found - A 3" dia. Brass cap mkd. T26S R2W S12 S6 S7 1972 RPLS 544 on a 2" I.D. Iron pipe, firmly set and protruding 8" above ground. *PROT 12"*

BURNED DEAD NOW 24" X 24" DOUBLE TRUNK
13" Fir now a 15" DBH D.Fir with a fully healed double blaze, bears N.6°E., 10.1 ft. *NO 2°E, 8 1/2"* *ADDED 3 1/2" MAG NAIL R.S.C.*

BURN TO GROUND (SAME AS 13" D FIR ABOVE)
An 11" Fir now a 13" DBH D.Fir with a fully healed double blaze, bears S.48 1/2°E, 32.8ft. *TO REMAINS*

A USFS metal witness sign and post bears South 4.5ft. previously unrecorded.

We add original 1910 closing corner as set by Mensch:

This closing corner is monumented by the original 16x12x12 basalt stone, now a broken 12x7 in. stone protruding 2" above ground with no marks visible. (We do not disturb)

Garrett's 1/2" I.P. on E. edge of stone protruding approx. 3" above ground. This iron pipe bears West, 12.04ft. from brass cap monument. (agrees w/record M 47-7)

Monument is on East edge of old clear cut on a still definite N-S cutting line and is South approx. 350 ft. from a creek coursing N.75°E.

NEW REF

BURNED DEAD 29" D. FIR WITH 3 1/2" MAG NAIL R.S.C. BEARS S 18° E, 26 1/2 FT

*CS 67/59-15
414*