

GOVERNMENT CORNER RESTORATION FORM

FILED

TOWNSHIP 25S RANGE 3W SEC. 32 PLSS # 240100

Date: 12/5/2024 By: JC

This survey consists of:

Map: _____

DOUGLAS COUNTY OREGON

DATE 11-26-24

Narrative: _____

Corner Rpt: CS67/59-17

Corner Designation

$\frac{1}{4}$ $\frac{S32}{S5}$

DOUGLAS COUNTY SURVEYOR

Monument(s) Found: (Condition and Source)

___ Condition report

GLD BRASS CAP IN

___ Not Found

MOUND OF STONE

Renewed

PROJ 18"

___ Unrecorded

Previous Renewals

___ Surveyed In

GLD Resurvey 1940 Vol 27 pg 11502

DCSD 1965 CS 54/7-1

MONUMENT DETAIL

BLM Resurvey 1987-1988

Vol 48 pg 18476

DCSD 2007 CS 67/24-44

$\frac{1}{4}$ $\frac{S32}{S5}$

Accessories Found

15" Rotted FIR STUMP N83 1/2° E 15.8 FT

13" Rotted FIR STUMP S22 1/2° E 12.5 FT

12" W. OAK N44 1/2° W 29.7 FT (REC 45 LKS)

20" Ponderosa Pine S85° E 9.9 FT (REC 15 LKS)

NEW TAG'S AND SIDE SPOKE BEARING TREES

C.S. File 67/59-17

Monument Set: (Procedure and Description)

MONUMENT DETAIL

Horizontal lines for Monument Set description.

New Accessories

Horizontal lines for New Accessories description.

Sketch of Monument, Accessories, and General Area

Location & Comments


OCRS COORDINATE SYSTEM
COTTAGE GROVE - CANYONVILLE
ZONE

N 186 447. 456

E 231 405. 342

Comp. Decline. 14/14° E
Agency DCSD
Party Chief J LORSUNG
Note keeper
Witnesses

CS 67/59-17
214

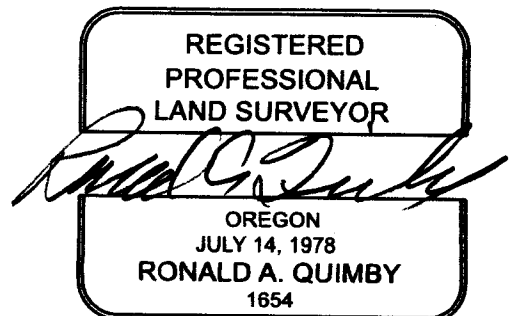

EXPIRES: 12/31/2024
26

TOWNSHIP 25 RANGE 03 POINT IDENTIFIER # 240100

PRIMARY CORNER DESCRIPTION ¼ Sec. Cor. for 32; & 5 of T 26-3

Alias _____	Description _____
Alias _____	Description _____
Alias _____	Description _____
Alias _____	Description _____

Original - Addison R. Flint, Contract #56 dated March, 1855 (DCSO Records, Volume 9 Page 3663)

Set Qr. sec. post, from which

- A B.Oak 6" dia., bears S.16°E., 90 lks. dist.
- A W.Oak 3" dia., bears North, 42 lks. dist.

GLO Dependent Resurvey by Norman D. Price, Under Special Instructions dated April 5, 1940 (DCSO records, Volume 27 Page 11502)

Point for orig. ¼ sec. cor., determined by reference to the record measurements from the original bearing trees. At point for corner, Set an iron post 3 ft. long, 1" dia., 18" in the ground to bedrock, and in a mound of stone to top, for ¼ sec. cor., with brass cap mkd. ¼ S32

S5
1943 from which

- A W.Oak dead and down, 12" dia., bears North, 42 lks. dist., with blaze decayed. (Old BT)
- A B.Oak 16" dia., bears S.27°E., 90 lks. dist. with blazed decayed. (Old BT)
- A Fir 15" dia., bears N.83½°E., 24 lks. dist. mkd. ¼ S32 BT. (New BT)
- A Fir 13" dia., bears S.22½°E., 19 lks. dist., mkd. ¼ S5 BT. (New BT)

Douglas Co. Surveyors Office - Bruce R. Rogers, Deputy; Wm. Stoffel; Mike Stone - July 15, 1965 - C.S. File 54/7-1

Found - / Orig. 16" B.Oak S.11°E., 90 lks., now low cut stump.
 ROOT NUL - / Orig. 12" W.Oak North 32 lks., now fallen snag.
 ROTTED - / 15" Fir (1943 resurvey) N.83½°E., 24 lks., now stump, scribing visible.
 / 13" Fir (1943 resurvey) S.22½°E., 19 lks., now stump scribing visible.

New BTs - 11" Oak S.63°W., 23.6 ft. mkd: ¼ S5 CS BT.
 7" Oak N.45°W., 29.6 ft. mkd: ¼ S32 CS BT.

Bureau of Land Management Dependent Resurvey - Wayne Rogers et al - Under Group #1386 - Survey June, 1987-Sept. 1988 (DCSO records, Volume 48 Page 18476)

TOWNSHIP 25 RANGE 03 POINT IDENTIFIER # 240100

PRIMARY CORNER DESCRIPTION 1/4 Cor. Sec. 32; & 5 of T. 26-3

Alias _____ Description _____
Alias _____ Description _____
Alias _____ Description _____
Alias _____ Description _____

Found the 1/4 sec. cor. of secs. 5 and 32, monumented with an
iron post, 1" dia., firmly set, projecting 15" above ground
with properly marked brass cap. (1943)
from which bearing tree mkd. by Bruce R. Rogers, Deputy County
Surveyor, in 1965 ^R
✓ A W. Oak 10" dia., bears N.44 1/2°W., 45 lks. dist., with
healed blaze.
and a new bearing tree ^W
✓ A Ponderosa Pine 15" dia., bears S.85°E., 15 lks. dist.,
mkd. 1/4 S5 BT.
Corner is located on SW. slope.

Douglas Co. Surveyors Office - Stephen J. Flause - John Pike
- 11/6/2007 - C.S. File 67/24-44

Found ok as per BLM renewal of 1987-1988

OCRS - 186447.456, 231405.342
NEW TAGS, SPIRES, NO Flagging DUE to CATTLE

CS 67/59-17
4/4