

GOVERNMENT CORNER RESTORATION FORM

FILED

TOWNSHIP E55 RANGE 3W SEC. 26

PLSS # 520200

Date: 12/11/2024 By: JC

This survey consists of:

Map: _____

Narrative: _____

Corner Rpt: C567/59-22

DOUGLAS COUNTY OREGON

DATE 12-4-24

DOUGLAS COUNTY SURVEYOR

Corner Designation

SEC COR 27/26
34/35

Monument(s) Found: (Condition and Source)

___ Condition report

1943 GLD BRASS CAP

___ Not Found

11" ABOVE GROUND. Cap

___ Renewed

leans slightly East in rough mound of Stone.

___ Unrecorded

Previous Renewals

___ Surveyed In

PRICE GLD Resurvey 1940

Vol 27 pg 11553-54

DCSB 1966 CS 54/27-2

JULIANO 1976 CS 58/130

BLM Resurvey 2008 Vol 57

Pgs 22429-30

MONUMENT DETAIL

T255 R3W

527/526

534/535

1943

Accessories Found

- DECAYED - BURNT 18" X 3 1/2" FT FIR STUMP
S 15 1/2° E 40.9 ft. Blaze heal visible
- BURNT - BARKLESS 42" X 30 FT FIR SNAG
N 82 1/4° W 39.0 FT (REC 38.3 FT) BURNT BLAZE
ADD 3 1/2" MAG NAIL LEFT SIDE CENTER
- BURNT DEAD 18" Hemlock S 50 1/4° E 37.6 FT
Fully Healed Double BLAZE ADD 3 1/2" MAG
NAIL RIGHT SIDE CENTER
- SAWN BURNT 9" X 1 FT PISTOL BUTT FIR
STUMP N 45 3/4° E 42.6 FT (REC 42.8 FT)
PARTLY HEALED BLAZE Scribes visible
ADD 3 1/2" MAG NAIL TOP CENTER
- BURNT - DEAD 13" FIR N 60 3/4° W 7.4 FT
Healed single BLAZE ADD 3 1/2" MAG
NAIL RIGHT SIDE CENTER
- Burned, sawed, decayed Pinestump S 18° W 44.2 ft

C.S. File 67/59-22

RENEWAL

Monument Set (Procedure and Description)

MONUMENT DETAIL

New Accessories

Burnt - DEAD 20" D. FIRE N 21° E 2.2 FT
Add 3 1/2" MAG NAIL RIGHT SIDE CENTER
Very old ILLEGIBLE yellow TAG

Sketch of Monument, Accessories, and General Area

Location & Comments

OCRS COORDINATE SYSTEM,
COTTAGE GROVE - CANYONVILLE
ZONE


AREA BURNT
9/2020

N 192024.706
E 244733.770

Comp. Decline. 14 1/4° E
Agency DCSO
Party Chief S. F. LAUSE
Note keeper
Witnesses J. Korsung

CS 67/59-22

24

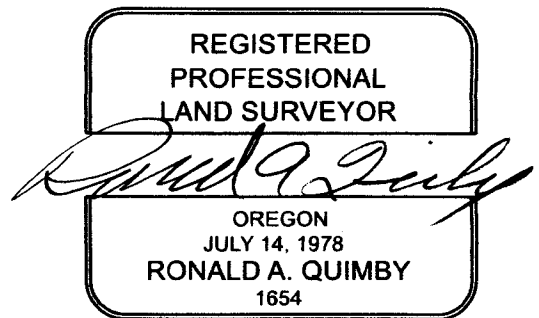

EXPIRES: 12/31/2024

26

PRIMARY CORNER DESCRIPTION Sec. Cor. for 26, 27, 34 and 35

Alias _____	Description _____
Alias _____	Description <u>OAS CANYONVILLE COTTAGE GROVE COORDS</u>
Alias _____	Description _____
Alias _____	Description <u>192024.706</u>
	<u>244733.770</u>

Doug. County Surveyors Office - Vernon Tracy; Joe Brady; Jack Heritage - June/July 1966 - C.S. File 54/27-2

Found - 1943 GLO brass cap mkd.
 Orig. 12" Dogwood N.19°E., 23.8 ft. shows fragmentary scribe, alive.
 Orig. 30" Fir, now snag N.45°W., 29.7 ft., not opened.
 10" now 15" S.Pine N.19½°E., 14.5 ft., alive, shows good scar.
 48" now 57" Fir N.82½°W., 38.3 ft., alive, face pitched over.
 SE and SW BTs, now stumps.

New BTs - 10" Hemlock S.7½°W., 39.8 ft. mkd. T25S R3W S34 CSBT
 14" Hemlock S.51°E., 37.8 ft. mkd. T25S R3W S35 CSBT

This cor. lies in NW corner of cut off unit.

Found OK, Nick Juliano, Dec. 1976, C.S. 58/130

BLM Dependent resurvey by A. Bert Skeesick & Kenneth W. Saveland, Cadastral Surveyors and Robert H. Browning, Survey Tech, under Group No. 2212 surveyed July/Oct. 2008 - (DCSO records Vol. 57 Page(s) 22429-30)

DECLINATION 14 1/4° E ----- *RENEWED 12/4/24*

The cor. of secs. 26, 27, 34, and 35, perpetuated by the Douglas County Surveyor's Office in 1966, monumented with an iron post, 2" dia., firmly set, projecting 11" above ground, with brass cap (properly) mkd. *CAP LEANS SLIGHTLY EAST IN ROUGH MOUND*
from which the remains of the original bearing trees *OF STONE*

GONE - A decayed hemlock stump, size indeterminate, bears S.50½°E., 26.4 ft., with no marks visible.

GONE - A burned, decayed fir stump, 19" dia., bears N.45°W., 29.7 ft., with no marks visible on an open blaze and the remains of bearing trees mkd. by Price

GONE - A decayed pine stump, size indeterminate, bears N.19½°E., 14.5 ft., with no marks visible.

DECAYED BURNED 18" x 3 1/2" STUMP - A sawed, decayed fir stump, 28" dia., bears S.15½°E., 40.9 ft., with no marks visible. *BLZ HEAL VISIBLE*

BURNED NOW BURNED - A sawed, decayed hollow pine stump, 72" dia., bears S.18°W., 44.2 ft., with no marks visible. *392 FT*

BARKLESS 42" x 30 FT. - A fir snag 56" dia., bears N.82½°W., 38.3 ft., with axe marks visible on a healed blaze. *BLZ BURNED ADD 3 1/2" MAG NAIL LSC*

and a BT mkd. by the Douglas County Surveyor's Office

BURNED DEAD 18" - A hemlock, 17" dia., bears S.50½°E., 37.6 ft., with fragmentary scribe marks visible on a partially *healed* double blaze. *FHDB*

continued next page

TOWNSHIP 25 RANGE 03 POINT IDENTIFIER # 500200

PRIMARY CORNER DESCRIPTION Cor. Secs. 26, 27, 34, & 35

Alias _____	Description _____
Alias _____	Description _____
Alias _____	Description _____
Alias _____	Description _____

PISTOL BUTT

and new bearing trees

SAWN BURNED

9" X 1 FT - AD STUMP

fir, 8" dia., bears N.45 $\frac{1}{2}$ °E., ~~42.8~~ ^{42.6} ft., mkd. T25S R3W

ADD 3 1/2" MAG NAIL TOP CNTR.

S26 BT. **PHBLZ. SCRBB VIS.**

GONE NO EVIDENCE

fir, 4" dia., bears S.72 $\frac{1}{2}$ °W., 32.3 ft., mkd. X at breast height and BT at base.

BURNED DEAD 13"

A fir, ~~12"~~ dia., bears N.60 $\frac{1}{4}$ °W., 7.4 ft., mkd. T25S R3W
S27 BT. **FHSB**

Corner is located on a gradual, broken, SE. slope.

NEW REF

BURNED DEAD 20" D. FIR; 3 1/2" MAG NAIL RSC BEARS N 21° E, 2 2/3 FT

ALSO A VERY OLD ILLEGIBLE YELLOW TAG

CS 67/59-22

414