

GOVERNMENT CORNER RESTORATION FORM

FILED

TOWNSHIP 26S RANGE 3W SEC. 2

PLSS # 54060

Date: 12/11/2024 By: JC

This survey consists of:

DOUGLAS COUNTY OREGON

DATE 12-4-24

Map: _____

Narrative: _____

Corner Rpt: CS67/59-23

Corner Designation

CN 1/4 S2

DOUGLAS COUNTY
SURVEYOR

Monument(s) Found: (Condition and Source)

5/8" Iron Rod 0.3
Above Ground

___ Condition report

___ Not Found

Renewed

___ Unrecorded

___ Surveyed In

Previous Renewals

CHRISTENSEN 1999 M133-77

MONUMENT DETAIL

Accessories Found

Down Burnt 9" D. Fir out of position
Root Hole N22°E 14.8 FT

Burnt Dead 17" D. Fir N88°W 49.2 FT
(Rec 49.9 FT)

Steel Fence Post 1.0 FT South

RENEWAL

Monument Set (Procedure and Description)

MONUMENT DETAIL

New Accessories

BURNT DEAD 13" J. CEDAR 54 7 1/2° E
 19.8 FT 3 1/2" MAG NAIL RIGHT SIDE
 CENTER

Sketch of Monument, Accessories, and General Area

Location & Comments

OCRS Coordinate System
 Cottage Grove - Canyonville
 Zone


AREA BURNT
 9-2020

N 184988.340
 E 247257.334

Comp. Decline. 14 1/4° E
 Agency DCSO
 Party Chief S. FIAUSE
 Note keeper
 Witnesses J. LORSON

CS 67/59-23

2/3

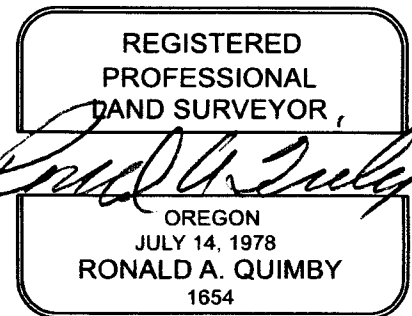

EXPIRES: 12/31/2024


26



REFERENCES

- (1) 1882 G L D (SAMUA
- (2) 1995 BLM RESURVE
- (3) 1963 BLM RESURVE
- (4) M56-34 (INVALIDA
- (5) CS 51/87 CALDER
- (6) CS 51/306 BARTA

Scale: 1"=600 ft

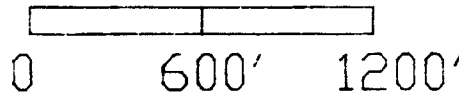

CORNER NOTES

- (1) SECTION CORNER 34-35/3-2
 FOUND: 1943 G L D 2 1/2' B C, 0.9 FT ABOVE GROUND
 BTS: 46' D. FIR, N01E, 21.4 FT., HEALED FACE, STUMP
 5' D. FIR, N56E, 10.9 FT., HEALED FACE
 10' D. FIR, S26E, 41.9 FT., HEALED FACE
 43' D. FIR, S45W, 6.6 FT., HEALED FACE
 23' CEDAR, N62W, 12.5 FT., HEALED FACE
 SET STEEL FENCE POST 1 FOOT NORTH
- (2) 1/4 CORNER SECTION 35/2
 FOUND: 1997 G C S D 2 3/8' B C, 0.7 FT. ABOVE GROUND
 BTS: 12' D. FIR, N45E, 22.1 FT., SCRIBING VISIBLE
 13' D. FIR, S33E, 24.1 FT., SCRIBING VISIBLE
 7' D. FIR, S87W, 20.0 FT., SCRIBING VISIBLE
 7' D. FIR, N56W, 20.7 FT., SCRIBING VISIBLE
 50' D. FIR, S51W, 34.0 FT., SCRIBING VISIBLE, STUMP
 38' CEDAR, N48W, 44.0 FT. (TO CENTER), ROTTEN-BURNT SNAG
 17' W. HEMLOCK, S25W, 68.2 FT., HEALED FACE
- (3) SECTION CORNER 35-36/2-1
 FOUND: 1943 G L D 2 1/2' B C, 0.6 FT. ABOVE GROUND
 BTS: 34' D. FIR, N57W, 26.9 FT., HEALED FACE
 34' D. FIR, S84W, 33.4 FT., HEALED FACE, STUMP, 8" NAIL-TOP CE
 44' D. FIR, S72E, 53.4 FT., '
 38' D. FIR, N30E, 6.3 FT., '
- (4) N 1/16 CORNER SECTION 3-2
 FOUND: 1995 B L M 3.0' B C, 0.1 FT. ABOVE GROUND
 BTS: 9' D. FIR, S89E, 18.1 FT., SCRIBING VISIBLE
 9' D. FIR, N19E, 6.8 FT., SCRIBING VISIBLE
 FOUND: 1.25" I. PIPE, N02°38'57"E, 3.21 FT. (BARTA)
 SET STEEL FENCE POST 1 FOOT EAST

CCRS CANYONVILLE COTTAGE GROVE COORDS

184988.340 N
247257.334 E

- (5) NW 1/16 CORNER SECTION 2
 SET: 5/8" X 30" REBAR /W YPC "LS 2603", 0.3 FT. ABOVE GROUND
 BTS: 9' D. FIR, N59W, 16.5 FT, BLAZED & SCRIBED "NW 1/16 S2 BT"
 15' D. FIR, S65W, 13.8 FT, DECLINATION 14 1/4 E RENEWED 12/4/24
 SET STEEL FENCE POST 1 FOOT NORTH

MAP FILE M 33-77

- 9" ● CN 1/16 CORNER SECTION 2
 SET: 5/8" X 30" REBAR /W YPC "LS 2603", 0.3 FT. ABOVE GROUND
 BTS: 9' D. FIR, N22E, 14.8 FT, BLAZED & SCRIBED "CN 1/16 S2 BT"
 9' D. FIR, N88W, 49.9 FT, 49.2 FT. SCRIBG BURNED
 SET STEEL FENCE POST 1 FOOT SOUTH

FALLEN BURNED OUT OF POS.
BURNED DEAD

NEW REF.

BURNED DEAD 13" L CEDAR; 3 1/2" MAG NAIL RSC S 47 1/2 E, 19.8 FT.
CS 67/59-23