

GOVERNMENT CORNER RESTORATION FORM

FILED

TOWNSHIP 25S RANGE 3W SEC. 1 PLSS # 700700

Date: 12/11/2024 By: JC
This survey consists of:

DOUGLAS COUNTY OREGON

DATE 12-9-24

Map: _____
Narrative: _____
Corner Rpt: CS 67/59-25

Corner Designation

Township 36/31
1 6

DOUGLAS COUNTY
SURVEYOR

Monument(s) Found: (Condition and Source)

3 1/2" 1943 GLD BRASS CAP
ON 3" IDIP PROJ 2" IN
ROUGH MOUND OF STONE

___ Condition report

___ Not Found

Renewed

___ Unrecorded

___ Surveyed In

Previous Renewals

GLD 1900 Vol 9 pg 3656
GLD 1940 Vol 27 pg 11519-26
BLM Resurvey 1951-1963
Vol 32 pgs 13284-85
DCSD 1966 CS 54/27-128
EDWARDS 2019 CS 65/82-13

MONUMENT DETAIL

T24S
R3W T2ZW
536/531
51/56
T25S

Accessories Found

BURNED - ROTTED 45" X 7 FT FIR STUMP
N52°W 42.2 FT (REC N50 1/2°W) NO MARKS
VISIBLE

BURNED ROTTED 50" X 6 FT FIR STUMP N37°E
26.9 FT (REC 26.4 FT) NO MARKS VISIBLE

BURNED OFF 16" X 6 FT D. FIR SWAG N150°E 48.0 FT
(REC N152°E 48.4 FT) BLAZE BURNT OFF

BURNED OFF 27" X 6 FT D. FIR SWAG S44°E 6.0 FT
PARTLY HEALED BLAZE FACE GONE

BURNED OFF 16" X 7 FT D. FIR SWAG S45°W 37.4 FT
REC (S43°W) FACE BURNT OFF

BURNED OFF 20" X 6 1/2 FT D. FIR SWAG N110°W
29.1 FT FACE BURNT OFF

Steel fence post Reset 2.0 FT South
5.6 FT Steel Channel Post 2.0 FT North

ALL trees have 3/2" mag nail RSC added C.S. File 67/59-25

RENEWAL

Monument Set (Procedure and Description)

MONUMENT DETAIL

New Accessories

Sketch of Monument, Accessories, and General Area


Location & Comments

OCRS COORDINATE Reference
System
Cottage Grove - Canyonville
Zone

AREA BURT
9-2020

N 218 758. 988
E 255547. 145

Comp. Decline. 14 1/4° E
Agency DCSO
Party Chief S. F. HAUSE
Note keeper
Witnesses J. Korslund

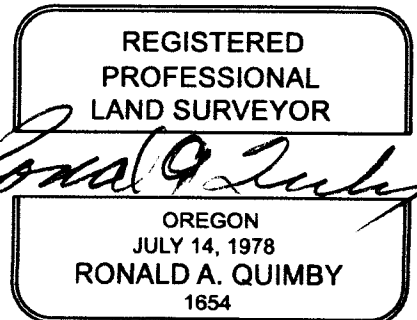

EXPIRES: 12/31/2026

CS 67/59-25
2/4

TOWNSHIP 25 RANGE 03 POINT IDENTIFIER # 700700

PRIMARY CORNER DESCRIPTION NE. Cor. Section 1 (NE. Tsp. Cor)

Alias _____ Description _____
 Alias _____ Description _____
 Alias _____ Description _____
 Alias _____ Description _____

In 1951, the iron post set in 1943 has been displaced in logging operations and is found lying on the surface; the original NE. bearing tree is gone.

At the corner point

Reset the iron post 36" long, 3" dia., 20" in the ground to solid rock, and in a mound of stone, 4 ft. base to top, with brass cap mkd. T 24 S

R 3 W	R 2 W
S 36	S 31
S 1	S 6
T 25 S	

from which

- A Fir 50" dia., bears N.77½°E., 252 lks. dist., mkd. T24S R2W S31 BT. (1951 BT)
- A dead Fir 50" dia., bears S.13½°E., 38 lks. dist., with blaze burnt. (1943 BT, rec. brg. S.18½°E.)
- A dead Hemlock 14" dia., bears S.7½°E., 37 lks. dist., with blaze burnt. (Orig. BT; 1943 rec. brg. S.11¼°E.)
- A dead Hemlock 20" dia., bears S.20½°W., 19 lks. dist., with blaze burnt. (orig. BT)
- A Fir 50" dia., bears S.41½°W., 51 lks. dist., mkd. T25S R3W S1 BT.
- A sawed Fir stump 48" dia., bears N.52°W., 64 lks. dist., with blaze burnt. (Orig. BT; 1943 rec. brg. N.50½°W.)

Douglas County Surveyors Office - Vernon Tracy; Joe Brady; Jack Heritage - July/Aug. 1966 - C.S. File 54/27-128

Found - GLO brass cap, 1943, mkd. and stumps of orig. BT. 48" now 50" Fir N.50½°W., 42.2 ft., shows fragmentary scribe on burned face. Rescribe "T25S R3W S1 CS BT".

All other BTs gone or out of place due to logging.

New BT - 54" D.Fir (stump 8 ft. high), N.37°E., 26.4 ft. mkd. T24S R2W S31 CS BT.

No other trees available. Corner lies in greasewood thicket, 20 ft. East of cat road and 20 ft. West of bottom of small draw.

David Edwards - Brant Miller - 1/11/2014 - C.S. 65/82-13

Found, ^{3 1/2" ON 3" 100.1.P} 1943 GLO Brass Cap. (properly mkd) ^{AS IN 1943 RESURVEY} PROT. 2" IN ROUGH MOUND OF STONE

BURNED ROTTED 45" x 7 STUMP

BURNED ROTTED 50" x 6 STUMP

50" dia. Fir stump bears N.50½°W., 42.2 ft. No marks visible.

54" dia. Fir stump bears N.37°E., 26.4 ft. No marks visible.

Fd a steel fence post set ^{52°} 1 ft m/l South of brass cap. ^{26.9} RESET 2.2 FT SOUTH

continued next page

ALL FOUND TREES HAVE 3 1/2" MAG NAIL RSC ADDED

CS 67/59-25

3/4

OVER

TOWNSHIP 25 RANGE 03 POINT IDENTIFIER # 700700

PRIMARY CORNER DESCRIPTION NE. Cor. Section 1 (NE Tsp. Cor)

Alias _____ Description _____
 Alias _____ Description CCRS CANYONVILLE COTTAGE GRAVE COORDS
 Alias _____ Description _____
 Alias _____ Description 218758.988 N

DECLINATION 14 1/4° E 255547.145 E

Set - A 5.5" tall steel channel post 2.0" North of brass cap.

BURNED OFF New 16"x6" SNAG 17" dia. D. Fir scribed "~~T245 R2W S31 BT~~" bears FACE GONE BURNED OFF
N. 57° E., 48.0 ft.

BURNED OFF 27"x6" SNAG 27" dia. D. Fir scribed "~~T255 R2W S6 BT~~" bears
S. 44° E., 6.0 ft. *BURNED PTH B FACE GONE*

BURNED OFF 16" X T SNAG 19 1/2" dia. D. Fir scribed "~~T255 R3W S1 BT~~" bears FACE BURNED OFF
S. 45° W., 37.4 ft.

BURNED OFF 20"x6 1/2" SNAG 21" dia. D. Fir scribed "~~T243 R3W S36 BT~~" bears FACE GONE BURNED OFF
N. 10° W., 29.1 ft.

Note - All measurements to 16d nail in tree side center.
 Compass decl. 15 1/4° E. NAILS NOT FOUND