

GOVERNMENT CORNER RESTORATION FORM

FILED

TOWNSHIP 24S RANGE 1W SEC. 17 PLSS # 200440

Date: 12/11/2024 By: JC

This survey consists of:

DOUGLAS COUNTY OREGON

DATE 12-10-24

Map: _____

Narrative: _____

Corner Rpt: CS 67/59-27

Corner Designation 1/4 COR 18/17

DOUGLAS COUNTY SURVEYOR

Monument(s) Found: (Condition and Source)

___ Condition report

2 1/2" DCSO BRASS CAP ON

___ Not Found

1" I.D.I.P PROJ 8" IN

Renewed

ROUGH MOUND OF STONE BRDLY

___ Unrecorded

Previous Renewals BENT 0.6 FT ± S50°E

___ Surveyed In

DCSO 1962 CS 52/42-20

DCSO 1967 CS 52/42-55

MONUMENT DETAIL

DOUGLAS COUNTY SURVEYORS OFFICE

T24S R1W

1/4 S18/517

1962

Accessories Found

BURNED - SAWN - ROTTED 48" X 4 FT SUGAR PINE STUMP N30°W 15.2 FT DOUBLE SCARS ADD BT TAG

SAWN FALLEN OUT OF POSITION SLID DOWN HILL 15' ± 22" X 7' FT D. FIR FULLY HEALED BLAZE WITH BT-TAG N 23°E 24.0 FT

SAWN 28" X 4 1/2 FT D. FIR STUMP S40°W 44.8 FT ALL SCRIBING VISIBLE ON UNHEALED BLAZE HAS BT TAG

Monument Set (Procedure and Description)

FOUND MONUMENTS PLUMB
POSITION REFERENCED REMOVE
AND STRAIGHTEN RESET MONUMENT
TO ORIGINAL POSITION NOW
PROJECTING 8" ADD ROUGH
MOULD OF STONE AROUND BASE

New Accessories

7" D. FIR S87°E 20.5 FT Scribed T24S
R1W S17 BT ON Double BLAZE 3 1/2" MAG
NAIL RIGHT SIDE CENTER


4" D. FIR S59°W 4.6 FT Scribed X BT
ON Double BLAZE ADD 3 1/2" MAG NAIL
RIGHT SIDE CENTER

Sketch of Monument, Accessories, and General Area

Location & Comments

WGS 84 Lat/Long:
N 43° 29' 16.19" W 122° 50' 24.41"

Comp. Decline. 14 1/4° E
Agency DCSO
Party Chief S. F. HAUSE
Note keeper
Witnesses J. LORSUNG

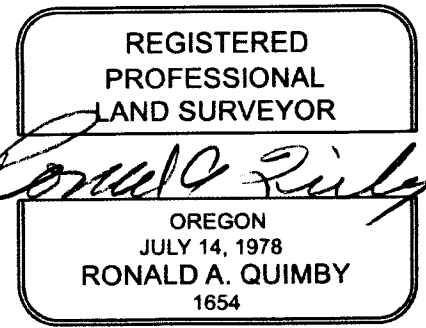

CS 67/59-27
213

PRIMARY CORNER DESCRIPTION 1/4 Cor. Secs. 17 & 18

Alias _____	Description _____
Alias _____	Description _____
Alias _____	Description _____
Alias _____	Description _____

GLO survey by Carl S. Nicklin, Dep. Surveyor under contract # 664, dated May 23, 1896 - (DCSO recs Vol. 7 Page(s) 2853)

Set a madrona post, 3 1/2 ft. long, & 3" sq., 24" in the ground for the 1/4 sec. cor. marked 1/4 S on W face, from which:

A fir, 14" dia., bears N.37°E., 19 lks., mkd: 1/4 S BT.

A fir, 54" dia., bears N.30°W., 23 lks., mkd: 1/4 S BT.

This cor. is on a steep hillside, sloping SE about 100 ft. above creek last noted.

Douglas Co. Surveyors Office - Milo E. Godfrey, Deputy - V. Tracy; M. Stone, crew - July/Aug. 1962 - C.S. File 52/42-20

NO EVIDENCE

Found - ~~Ponderosa Pine~~ (instead of Fir) 17" dia., ~~N.37°E.~~, 12.5 ft. Opened scar & fd. good scribing "1/4"

SAWN, BURNED, ROTTED - 54" dbl. sugar pine (instead of Fir) N.30°W., 15.2 **48" X 4 FT. STUMP** ft. Two very plain scars **ADD BT TAG**

Set - Brass cap at cor. mkd: COUNTY SURVEYORS OFFICE 1962 T24S R1W 1/4 S18|S17

Blaze & scribe 1 new BT

21" D. Fir N.23°E., 24.0 ft. mkd: 1/4 S17 CS BT.

DECLINATION 14 1/4° E

RENEWED 12-10-2024

Douglas County Surveyors Office - Vernon "Ray" Tracy and crew June 15, 1967 - C.S. File 52/42-55

Found - 1962 Co. Surveyor brass cap & BTs, properly marked. Both orig. BTs now turned out & slid down very steep, SE slope. - **NOT CORRECT, SEE ABOVE**

21" D. Fir ~~N.23°E.~~ 24.0 ft. alive, face pitched over **FIR HAS TAG**

New BT - 28" ~~D. Fir~~ S.40°W. 44.8 ft. mkd: 1/4 S18 CS BT **ALL SCRIBING VISIBLE ON UNHEALED BLZ. HAS BT TAG**

Note - This corner lies on steep, SE slope. **SAWN 28" X 4 1/2" STUMP**

FOUND MONUMENTS PLUMB POSITION IS REFERENCED OUT. MONUMENT IS REMOVED FROM GROUND AND STRAIGHTENED. MONUMENT IS RETURNED TO PLUMB POSITION AND NOW PROT. 8" ABOVE GROUND. A ROUGH MOUND OF STONE ADDED AROUND BASE.

NEW REFS.

A 7" D. FIR SCRIBED "T24S R1W S17 BT" ON A DBL. BLAZE WITH A 3 1/2" MAG NAIL RSC BEARS S 87° E, 20 1/2 FT. DISTANT.

A 4" D. FIR SCRIBED "X BT" ON A HIGH-LOW BLAZE WITH A 3 1/2" MAG NAIL RSC BEARS S 59° W, 4 1/2 FT. DISTANT.

Jean Crawford

From: Dan Saily
Sent: Monday, December 16, 2024 1:10 PM
To: Jean Crawford
Subject: RE: coordinates for 1*4 Secs 17 & 18 T24-1

-
Jean,
The WGS 84 Lat/long is: N43°29'16.19", W122°50'24.41"

Thank you all for doing this corner renewal.

Dan