

GOVERNMENT CORNER RESTORATION FORM

FILED

TOWNSHIP 255 RANGE 2W SEC. 17

PLSS # 240400

Date: 1/2/2025 By: X
This survey consists of:

Map: _____

DOUGLAS COUNTY OREGON

DATE 12-17-24

Narrative: _____
Corner Rpt: CS 67/59-30

DOUGLAS COUNTY
SURVEYOR

Corner Designation

1/4 COR 17/20

Monument(s) Found: (Condition and Source)

3'14" BLM BRASS CAP WITH
1'14" I.D IRON PIPE ON
SOUTH EDGE

Previous Renewals

Mc Chesney 1957 CS 53/112-25
Hosford 1957 CS 42/302
BLM 1962 Vol 32 pgs 13239-40
BAUGHMAN 1976 M 56-35
Smalley 2008 C.S. 65/63-32

___ Condition report

___ Not Found

Renewed

___ Unrecorded

___ Surveyed In

MONUMENT DETAIL

1/4 517
520
T255 R2W
1962

Accessories Found

10" X 2 FT BURNED ROTTED FIR STUB S 68° W
7.3 FT (REC 11 LBS)
5" X 1 1/2 FT BURNED ROTTED BROKEN FIR STUB
N 70° W 19.4 FT
UN RECORDED B.T'S
19" X 2 1/2 FT SAWN BURNED HEMLOCK STUMP
S 16° W 17.8 FT ALUM. NAIL LEFT SIDE
CENTER BURNT FACE B.T STILL LEGIBLE
17" X 2 FT FIR STUMP S 60° W 12.0 FT
HEALED BLAZE ALUM NAIL LEFT SIDE
CENTER

C.S. File 67/59-30

Monument Set (Procedure and Description)

MONUMENT DETAIL

New Accessories

Sketch of Monument, Accessories, and General Area

Location & Comments

MON 150N steep South slope
Approx 50 North of narrow
bench in large Clearcut

MON 15 APPROX
200' SOUTH OF
GRAVEL ROAD


OCRS Coordinat system
Cottage Grove. Canyonville zone

Burnt 9/2020
Comp. Decline. 1470°E
Agency DCSO
Party Chief S. F. KAUSE
Note keeper
Witnesses J. LORSUNG

N 202319.589
E 2625830.661

CS 67/59-30

2/3

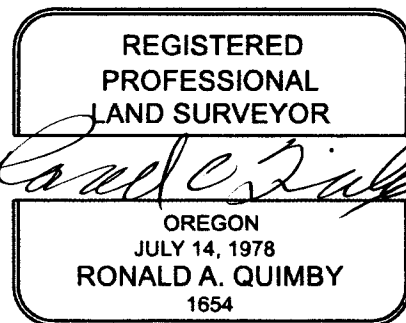

EXPIRES: 12/31/2026

TOWNSHIP 25 RANGE 02 POINT IDENTIFIER # 240400

PRIMARY CORNER DESCRIPTION 1/4 Cor Secs 17 & 20

Alias _____	Description _____
Alias _____	Description <u>DCRS CANYONVILLE COTTAGE GROVE COORD.S</u>
Alias _____	Description _____
Alias _____	Description <u>202319.589 N</u>
	<u>262583.661 E</u>

Set an iron post, 28" long, 2 1/2" dia., 24" in the ground & in a mound of stone, 2 ft. base, to top, with brass cap marked

$\frac{1}{4} \begin{array}{r} S 17 \\ S 20 \end{array}$
 T25S R2W
 1962

No suitable bearing tree available in Sec. 17.
Deposit iron pipe alongside the iron post.

Fd. Ok by G. Baughman, 1/1976 - M56-35

DECLINATION 14 1/4° E RENEWED 12/17/24

Mark Smalley, Roseburg Forest Products - Bill Olsen - Niel Danko - Aug. 5, 2008 - C.S. File 65/63-32

----- 56' - 3 1/4" MOF 5", 1 1/4" I.D. I.P. ON SOUTH EDGE

Found - 1962 2 1/2" iron post & brass cap (properly marked)

~~GONE - 20" cedar S. 41° E., 74 lks., rotten stump.~~

BURNED, ROTTED STUB 10" x 2 FT

~~32" Fir S. 68° W., 11 Yks., tall rotten stump healed blaze. BLZ, GONE 72'~~

~~New GONE - 14" Fir S. 62° E., 34.2 ft, scribed 1/4 S BT.~~

BURNED, ROTTED BROKEN 5" x 1 1/2" STUB

~~GONE - 16" W. Fir S. 18° E., 17.6 ft, scribed 1/4 S BT.~~

~~GONE - 12" Fir N. 58° E., 12.0 ft, scribed 1/4 S BT.~~

Compass ~~16° E.~~

~~FIND UNRECORDED REFERENCES~~

~~UN, BURNED 19" x 2 1/2 FT. HEMLOCK STUMP, ALUM. NAIL L.S.C. S16° W, 17 1/8 FT.~~

~~PARTIALLY HEALED BLAZE, BURNED FACE "BT" STILL LEGIBLE~~

~~ASAWN, BURNED 17" x 2 FT. FIR STUMP, ALUM. NAIL L.S.C. S60° W, 120 FT.~~

~~BOTTOM OF HEALED BLAZE REMAINS~~

~~MONUMENT IS ON STEEP SOUTH SLOPE APPROX 50 FT NORTH FROM NARROW BENCH. MONUMENT IS IN VERY LARGE CLEARCUT APPROX. 200 FT SOUTH FROM A GRAVELLED RD.~~

CS 67/59-30
3/3