

GOVERNMENT CORNER RESTORATION FORM

TOWNSHIP 255 RANGE 3W SEC. 20 PLSS # 240300

FILED
Date: 1/2/2025 By: SC
This survey consists of:

DOUGLAS COUNTY OREGON

DATE 12-17-24

Map: _____
Narrative: _____
Corner Rpt: CS 67/59-31

Corner Designation

1/4 COR 20/29

DOUGLAS COUNTY
SURVEYOR

Monument(s) Found: (Condition and Source)

GLO BRASS CAP ON
1" IRON PIPE PROJECTING
7"

- Condition report
- Not Found
- Renewed
- Unrecorded
- Surveyed In

Previous Renewals

GLO RESURVEY 1940 Vol 27 pg 11593
DCSO 1966 CS 54/27-29
EDWARDS 2002 M 140-45
QUINBY 2007 CS 65/60-18
BLM RESURVEY 2013 Vol 58
pg 229/6

MONUMENT DETAIL

1/4 520
529
1944

Accessories Found

BURNED Shell 23" Cedar STUMP S33°W
15.2 FT
BURNED DAWD 4" FIR N24 1/2° E 5.5 FT (RAC 5.0)
BURNED out BLAZE Legible Scribes ADD
3 1/2" MAG NAIL Right Side Center
BURNED - ROTTEN 3" FIR SWAG S82 3/4° E 4.3 FT
BLAZE GONE no nail added
10" X 5 FT Broken OFF Hemlock SWAG
S 12° E 24.0 FT PARTLY Healed Single
BLAZE Illegible Scribes Visible
Tree is side spiked -

RENEWAL

Monument Set (Procedure and Description)

MONUMENT DETAIL

New Accessories

BURNED- DEAD 6" Hemlock 535°E 10.2 FT
3 1/2" MAG NAIL RIGHT SIDE CENTER

BURNED SAWN 11" X 1 1/2" Hemlock Stump
N54°W 10.2 FT 3 1/2" MAG NAIL ADDED
TOP CENTER

Sketch of Monument, Accessories, and General Area

Location & Comments

clearcut in N.W. Quadrant
Rest BURNED SECOND GROWTH

MON IS 40 FT.
EAST OF ABANDONED
GRAVEL ROAD

OCRS COORDINATE SYSTEM
COTTAGE GROVE - CANYONVILLE
ZONE

AREA BURNED
9-2020

N 198458.217

E 221530.671


Comp. Decline. 14 1/4° E

Agency DCSO

Party Chief S. F. AUSE

Note keeper

Witnesses J. LORSUNG

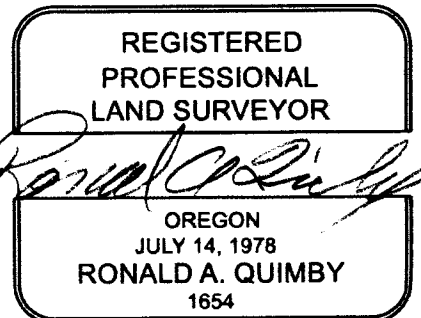

EXPIRES: 12/31/2026

CS 67/59-31

2/3

TOWNSHIP 25 RANGE 03W POINT IDENTIFIER # 240300

PRIMARY CORNER DESCRIPTION 1/4 Cor. for Secs. 20 and 29

Alias _____	Description _____
Alias _____	Description <u>CCRS CANYONVILLE COTTAGE GROVE CORN.S</u>
Alias _____	Description _____
Alias _____	Description <u>198458.217</u>
	<u>231530.671</u>

BLM Dependent Resurvey by A Bert Skeesick, Cadastral Surveyor Under Group No. 2500, Surveyed March/May 2012 - DCSO records BLM Plat 2013-1, T25-3 and Vol. 58 Page(s) 22976

DECLINATION 14 1/4° E

RENEWED 12/17/24

The 1/4 sec. cor. of sees. 20 & 29, perpetuated by the Douglas County Surveyor's Office in 1966, further perpetuated by Edwards, in 2002, monumented with an iron post, 1" dia., firmly set, projecting 7" above ground, with brass cap (properly) mkd.

from which the remains of a BT mkd. by Price sawed cedar stump, 23" dia., bears S.33°W., 15.2 ft., with scribe marks S29 CS BT visible on an open blaze, and an aluminum cover.

BURNED SHELL

and remains of BTs mkd. by the Douglas Co. Surveyor's Office GONE - A burnt, decayed cedar snag, 13" dia., bears N.34 1/2°E., 48.3 ft., with no marks visible on a burnt, hollowed blaze.

NOT CHECKD.

An uprooted, sowed cedar stump, 20" dia., bears S.29 1/4°W., 83.3 ft., with scribe marks 1/4 S29 CS BT visible on an open blaze, and an aluminum cover. (Disturbed by rood-building activity.)

and remains of BTs mkd. by Edwards 5.5 A fir, 5" dia., bears N.24 1/2°E., 5.0 ft., with scribe marks XI visible on a partially healed blaze. ADD 3 1/2" MAG NAIL R.S.C.

BURNED DEAD 4"

A fir snag, 5" dia., bears S.82 1/4°E., 4.3 ft., with scribe marks XI visible on a partially healed blaze. BLZ. BURNED BUT LEGIBLE

BURNED ROTTED 3"

and a new bearing tree BLZ. GONE NO NAIL ADDED

BURNED BROKEN OFF

- A hemlock, 9" dia., bears S.12°E., 24.0 ft., mkd. 1/4 S29 BT HAS SIDE NAIL

10" X 5 FT.

Corner is located 40 ft. E. of a groveled road, 12 ft. wide, SOME ILLEG. SCRIBES VISIBLE

CLEARCUT NW QUADRANT

NEW REFS REST BURNED SECND. GROWTH

BURNED DEAD 6" HEMLOCK 3 1/2" MAG NAIL R.S.C. S 35° E, 10 1/2

BURNED SAWN 11" X 1 1/2 FT HEMLOCK STUMP 3 1/2" MAG NAIL TOP CNTR. N 54° W, 10 1/2

CS 67/59-31
3/3