

GOVERNMENT CORNER RESTORATION FORM

FILED

TOWNSHIP 26S RANGE 4W SEC. 29 PLSS # 240200

Date: 1-9-2025 By: SC
This survey consists of:

DOUGLAS COUNTY OREGON

DATE 12-31-24

Map: _____
Narrative: _____
Corner Rpt: CS 67/59-36

Corner Designation

$\frac{1}{4}$ S 29
S 32

DOUGLAS COUNTY
SURVEYOR

Monument(s) Found: (Condition and Source)

___ Condition report

___ Not Found

Renewed

___ Unrecorded

___ Surveyed In

2 1/2" BRASS CAP

Previous Renewals

Established by Ruppert
1978 RM 3-15

Hibbs 2005 2005-0047 AB

MONUMENT DETAIL

T26S 4W

$\frac{1}{4}$ S 29
S 32

PLS 844
1978

Accessories Found

NONE

Monument Set (Procedure and Description)

MONUMENT DETAIL

New Accessories

Power Pole marked B-4010 N48°W
23° FT ADD PK

T. Post 0.5' NW

Set 5/8" x 30" T. Rods with DCSO
PLASTIC Caps
EAST 6.0 FT
WEST 5.0 FT

Sketch of Monument, Accessories, and General Area

Location & Comments


DCRS Coordinates
Cottage Grove - Canyonville
Zone

N 146408.826
E 157103.341

MON IS 5 FT
North of
Ester Lane

All trees that could be
mark on private property

Comp. Decline. 197°E
Agency DCSO
Party Chief J. Lorsburg
Note keeper
Witnesses

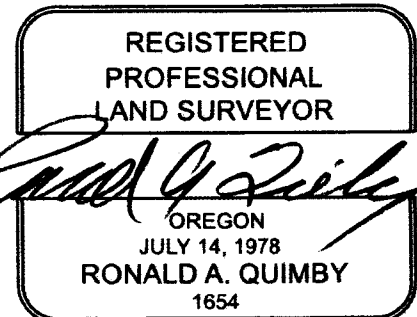

CS 67/59-36

2/3

TOWNSHIP 26 RANGE 04 POINT IDENTIFIER # 240200

PRIMARY CORNER DESCRIPTION 1/4 Cor. for Secs. 29 and 32

Alias _____	Description _____	12-31-24
Alias _____	Description _____	
Alias _____	Description _____	
Alias _____	Description _____	

Original - Addison R. Flint, Contract #56 dated March, 1855 (DCSO Records, Volume 11 Page 4453)

Set 1/4 sec. post to which there being no trees within reasonable distance, I raised a mound as per instructions.

William Ruppert, PLS #866 - For: Gamegan, Wilcox & Weathers May 1978 - RM 3-15

Set - 1" x 30" galv. steel pipe with 2 1/2" brass cap mkd: T26S R4W 1/4 S29 S32 PLS 866 1978.

Fd. Ok by Neil Hibbs Feb. 2005 - 2005-0047 A&B

OGRS N-146408.826, E-157103.741

PK SET → POWER POLE MARKED B-4010 BEARS N48W, 23° FT
T-POST 6 INCHES NW

SET - IR, EAST, 6°
SET - IR, WEST, 5°

5 FT NORTH OF FOSTER LANE, ALL TREES THAT COULD BE MARKED FALL ON PRIVATE PROPERTY.

CS 67/59-36
3/3